

MISSISSIPPI DEPARTMENT OF NATURAL RESOURCES

Bureau of Land and Water Resources

Southport Mall

P.O. Box 10631

Jackson, Mississippi 39209

CODED

WATER WELL DRILLERS LOG

Hancock
L 38

9/3/84
date well completed

Braden Pump & Well Drilling, Inc.
firm name

Hancock
county well located

LANDOWNER: Herald Baette
Pearlinton Ms. 39572
(mailing address)

description of formations encountered

from

to

WELL LOCATION:
sec. 20 T. 9 S. R. 16 E.
miles in direction W. (nearest town)

| | | |
|-------------|------|------|
| sand | 0 | 42 |
| clay | 42 | 80 |
| sand | 80 | 150 |
| clay | 150 | 230 |
| sand | 230 | 250 |
| sand | 250 | 400 |
| sand | 400 | 590 |
| clay | 590 | 1220 |
| sandstone | 1220 | 1248 |
| clay | 1248 | 1590 |
| sand | 1590 | 1620 |
| clay | 1620 | 1790 |
| sand | 1790 | 1830 |
| clay + sand | 1830 | 1880 |
| sand | 1880 | 1940 |

WELL PURPOSE: Home
(home, irrigation, municipal, industrial)

WELL COMPLETION DATA:

- (1) diameter (inches) 3"
- (2) total depth (feet) 1940
- (3) static water level (feet) flowing well 28# pressure below top of ground (40' above seal)
- (4) casing PVC (material) 1910 (depth)
3" (size) If telescope see back.
- (5) screen 30' (length) 1910 (depth to top)
3" (size) stainless steel (material)
- (6) pump (HP) 110 (yield gpm)
 (type power)
- (7) electric log yes (yes or no)
 (organization running log)
- (8) how well bottom plugged backfilled
check valve

DEPT. OF NATURAL RESOURCES
BUREAU OF LAND & WATER RESOURCES


OCT 22 1984

RECEIVED

DRILLERS REMARKS:

If well telescopes please sketch and show depths.

GROUND LEVEL

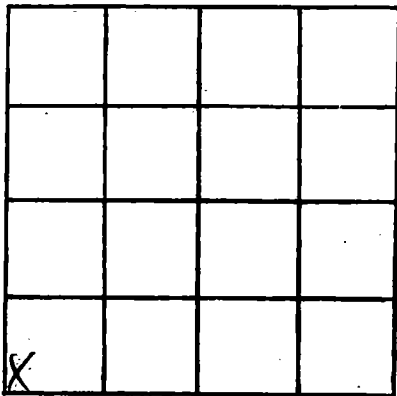

SECTION 20

Please indicate well location X.

ADDITIONAL INFORMATION

If more than one screen, show locations of each on sketch.