

MISSISSIPPI DEPARTMENT OF NATURAL RESOURCES

Bureau of Land and Water Resources

Southport Mall

P.O. Box 10631

Jackson, Mississippi 39200 **RECORDED**

WATER WELL DRILLERS LOG

HANCOCK
L 42
11-28-80

11-28
 date well completed

1980 Penton Well Serv
 firm name

Hancock
 county well located

LANDOWNER: W.L. Hodgins
Pearlington MS.
(Jim Kelly Rd)
 (mailing address)

description of formations encountered	from	to
Surface Clay	0	20
Sand + Clay	20	150
Blue Clay	150	200
Sand + Gravel	200	310
Blue Clay	310	500
Sand	500	600
Blue Clay	600	820
Sand	820	907

WELL LOCATION:

sec. 20 T. 9 N. R. 16 W. S. W.
1 miles East of Pearlington
 (distance) (direction) (nearest town)

WELL PURPOSE: home
 (home, irrigation, municipal, industrial)

WELL COMPLETION DATA:

- (1) diameter (inches) 2"
- (2) total depth (feet) 907'
- (3) static water level (feet) Flow below above top of ground.
- (4) casing Galv. 887'
 (material) (depth)
2" if telescope see back.
 (size)
- (5) screen 20' 887'
 (length) (depth to top)
2" S. Steel
 (size) (material)
- (6) pump _____ (HP) _____ (yield gpm)
 (type power)
- (7) electric log NO
 (yes or no)
 (organization running log)
- (8) how well bottom plugged BW Valve

DEPT. OF NATURAL RESOURCES
 BUREAU OF LAND & WATER RESOURCES


DEC 15 1980

RECEIVED

DRILLERS REMARKS:

If well telescopes please sketch and show depths.

GROUND LEVEL

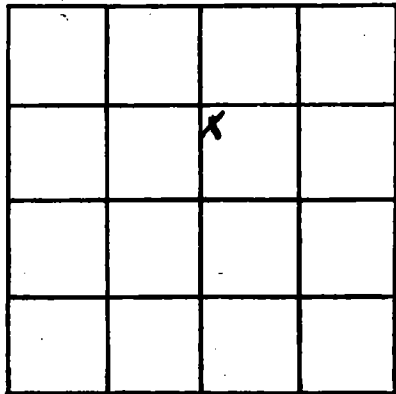

SECTION _____

Please indicate well location X.

ADDITIONAL INFORMATION

If more than one screen, show locations of each on sketch.