


HANCOCK

MISSISSIPPI BOARD OF WATER COMMISSIONERS

L68

4-5-65

WATER WELL DRILLERS LOG

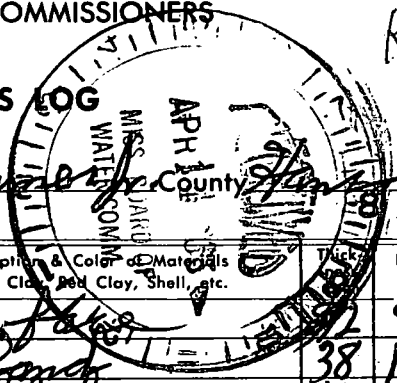

K

Date: 4-5, 1965, Driller: D. K. ... (Name)

(1) Owner of Land: W. A. Q. Hodges (Name)

Pearlington Miss. (Address) SUB DIV

(2) Location: 1/4, 1/4, Sec. T8R16, miles of (distance) (direction) (Nearest Town)

(3) Topography: Hilly (Hilly) (Flat) (Level)

(4) Purpose of Well: Domestic (Domestic Irrigation Municipal, Industrial, Other)

Description & Color of Materials Sand, Clay, Red Clay, Shell, etc.	Thickness	Depth Feet
Surface	2	92
Sand	38	130
Clay	15	145
Clay	26	171
Clay	104	275
Sand & Clay both	70	345
Clay	46	391
Clay	105	496
Clay	41	537
Sand	38	575
Clay	825	1400
Clay & Sand	187	1587
Clay	321	1908
Sand	130	2038

Information upon completion of well:

(1) Diameter 2" inches.

(2) Total Depth 2015 feet.

(3) Water Level 45 lb. Pressure feet below top of ground.

(4) Cased to 1995, Size 2"

(5) Screen: Size 2", Length 20ft.

(6) Were any formations sealed against pollution? yes, no.

If YES depth of formation

Why

Drillers Remarks:

(Use Back Side)

Well No.

