

L69  
3-1-65

WATER WELL DRILLERS LOG

CODED

Date: 3-1-1965, Driller: D. K. Summey, County: Hancock  
(Oak Harbor Subdv) (Name)

(1) Owner of Land: Deborah M. Littlejohn  
(Name)  
Jackson, Mississippi  
PO. BOX 8127 (Address)

(2) Location: 1/4, 1/4, Sec. 20 T. 9 R. 16  
1/2 miles E of Pearlington  
(distance) (direction) (Nearest Town)

(3) Topography: Hilly  
(Hilly) (Flat) (Level)

(4) Purpose of Well: Municipal  
(Domestic Irrigation  
Municipal, Industrial, Other)

Description & Color of Materials Sand, Clay, Red Clay, Shell, etc.	Thick- ness Feet	Depth Feet
Surface	34	34
Sand	26	60
Shell	20	80
Sand	40	120
Shell	20	140
Sand	30	170
Shell	170	340
Sand	16	356
Shell	50	406
Sand	10	416
Shell	84	500
Sand	138	638
Shell	66	704
Sand	12	716
Shell	76	792
Sand	29	814
Shell	46	860
Sand	57	917
Shell	679	1596
Sand	52	1648
Shell	236	1884
Sand	106	1990

CODED

Information upon completion of well:

(1) Diameter: 8" inches.

(2) Total Depth: 209 feet, 240-75

(3) Water Level: 44 3/4 ft. Pressure feet below top of ground.

(4) Cased to: 1930 ft. Size 6"


(5) Screen: Size 6", Length 60 ft.

(6) Were any formations sealed against pollution?  
 yes,  no.

If YES depth of formation: 20 ft.

Why: Board of Health, Regul.

Drillers Remarks: Well flows  
888 Gallons per Minute

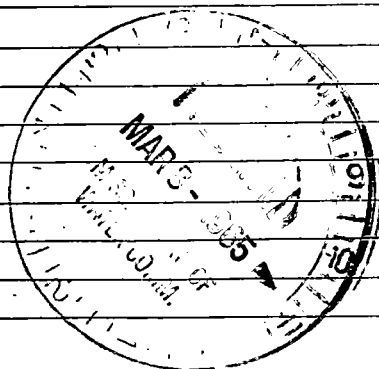

(Use Back Side)

Well No.

The U.S. G.S. Ran a Electric Log  
of this Well here Log no 40  
Well no L69

Well was Drilled at Oak Harbor  
Subdivision; Pearlinton, Miss