

MISSISSIPPI  
BOARD OF WATER COMMISSIONERS  
416 North State Street  
Jackson, Mississippi 39201

CODED

CODED

WATER WELL DRILLERS LOG

*Hancock*  
*OLB*  
*5-67*

*5-31* 19*67* *Penicill Water Works* *Hancock*  
date well completed firm name county well located

LANDOWNER:  
*O. S. J. Bay St.*  
*Louis, Miss*  
(mailing address)

description of formations encountered	from	to
<i>top soil &amp; soil</i>	<i>0</i>	<i>20</i>
<i>soft mixed sand</i>	<i>20</i>	<i>220</i>
<i>Red gravel &amp; sand</i>	<i>220</i>	<i>240</i>
<i>Blue mud &amp; Clay</i>	<i>240</i>	<i>450</i>
<i>good blueish sand</i>	<i>350</i>	<i>490</i>

WELL LOCATION:  
sec *35* T *9* N R *11* E  
*2* miles *West* off *By St*  
(distance) (direction) (nearest town)

WELL PURPOSE: *Home*  
(home, irrigation, municipal, industrial)

- WELL COMPLETION DATA:
- (1) diameter (inches) *2"*
  - (2) total depth (feet) *490'*
  - (3) static water level (feet) *8* below above top of ground.
  - (4) casing *2" gal* *480'*  
(material) (depth)
  - None* if telescope see back.  
(size)
  - (5) screen *10'* *480'*  
(length) (depth to top)
  - 2"* *sl. on gal.*  
(size) (material)
  - (6) pump *1/3*  
(HP) (yield gpm)
  - Elec.*  
(type power)
  - (7) electric log *None*  
(yes or no)
  - None*  
(organization running log)
  - (8) how well bottom plugged *2" B.*  
*Wash Valve*


*well was*  
*thru by a ch*  
*paid for by a ch*  
*man same it*  
*the the next*  
*the the*  
*neighbor*

DRILLERS REMARKS: *Sir, This*  
*Well was paid to me*  
*by a friend, the land*  
*owner is out of town*  
*I don't know how to get in touch*



If well telescopes please sketch and show depths.

GROUND LEVEL

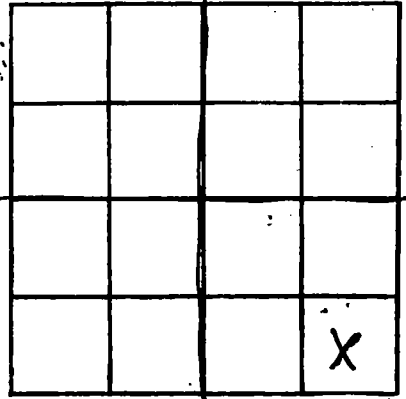

SECTION

*SB*

Please indicate well location X.

ADDITIONAL INFORMATION

If more than one screen, show locations of each on sketch.