

MISSISSIPPI
BOARD OF WATER COMMISSIONERS
416 North State Street
Jackson, Mississippi 39201

CODED

CODED

WATER WELL DRILLERS LOG

10-24
date well completed

1968

Sutter Well Works
firm name

Hancock
county well located

LANDOWNER: A. E. DANSEREAU

description of formations encountered

from

to

Pearlington,

Clay
sand

0 86
86 111

Miss.

(mailing address)

WELL LOCATION:

sec 21 T. 9 N R. 16 E
Belle Isle sub. division
miles (distance) (direction) (nearest town)

WELL PURPOSE: none
(home, irrigation, municipal, industrial)

WELL COMPLETION DATA:

- (1) diameter (inches) 2
- (2) total depth (feet) 111
- (3) static water level (feet) 4 below top of ground above
- (4) casing galv. 106'
(material) (depth)
2" (size) if telescope see back.
- (5) screen 5' 106'
(length) (depth to top)
2" stainless steel
(size) (material)
- (6) pump unknown
(HP) (yield gpm)


(type power)

(7) electric log no
(yes or no)

(organization running log)

(8) how well bottom plugged B.P. value

DRILLERS REMARKS:

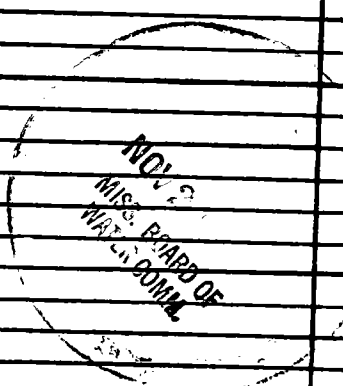

If well telescopes please sketch and show depths.

GROUND LEVEL

SECTION _____

Please indicate well location X.

ADDITIONAL INFORMATION

If more than one screen, show locations of each on sketch.