

HANCOCK  
 L 95  
 9-30-70  
 Sept 30 1970  
 date well completed

MISSISSIPPI  
 BOARD OF WATER COMMISSIONERS  
 416 North State Street  
 Jackson, Mississippi 39201

**CODED**

WATER WELL DRILLERS LOG

M & B Drilling Co. Hancock  
 firm name county well located

LANDOWNER: Don A. Aaraway  
 Jim Walter Home - New Orleans  
 (Bell ~~Home~~ Subdivision)  
 (mailing address)

description of formations encountered	from	to
Surface Swamp	0	15
Sand & Gravel	15	35
Sand & Clay	35	60
Sand	60	74
Clay	74	95
Sand	95	106
Blue Clay	106	110+

WELL LOCATION:  
 sec. 28 T. 9 S. R. 16 W.  
 1 miles S of Pearlinton  
 (distance) (direction) (nearest town)

WELL PURPOSE: River Camp  
 (home, irrigation, municipal, industrial)

WELL COMPLETION DATA:

- (1) diameter (inches) 2
- (2) total depth (feet) 110
- (3) static water level (feet) 2 below top of ground.
- (4) casing PVC Total  
 (material) (depth)  
2" (size) If telescope see back.
- (5) screen 6 FT / 100  
 (length) (depth to top)  
2" / PVC Sand Pac  
 (size) (material)
- (6) pump 1/2 / 8  
 (HP) (yield gpm)  
110 V 1P  
 (type power)
- (7) electric log No  
 (yes or no)
- (organization running log)
- (8) how well bottom plugged  
2" PVC Cap.

Other Driller Note  
 Well in 60 to 74 Sand  
 Water Clear & Salty  
 Glen Prodan  
 This 106 Sand good  
 Potable water

**CODED**


OCT 13 1970

MISS. BD. OF  
 WATER COMM.

DRILLERS REMARKS:

If well telescopes please sketch and show depths.

GROUND LEVEL

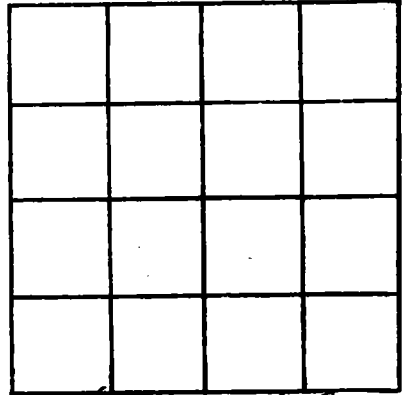

*Next to Pearl River*  
*South 11590 SECTION 28*

Please indicate well location X.

ADDITIONAL INFORMATION

If more than one screen, show locations of each on sketch.