

HANCOCK
L 96
11-29-70

MISSISSIPPI
 BOARD OF WATER COMMISSIONERS
 416 North State Street
 Jackson, Mississippi 39201

CODED

WATER WELL DRILLERS LOG

11-29-70 date well completed Ed J. Webster well serv. firm name HANCOCK county well located

LANDOWNER:	description of formations encountered	from	to
<u>W.S. Nelson</u>	<u>White Clay</u>	<u>0</u>	<u>47</u>
<u>Pearlington Miss.</u> (mailing address)	<u>Coarse white sd.</u> <u>& Gravel</u>	<u>47</u>	<u>65</u>
WELL LOCATION: sec. <u>7</u> T. <u>9</u> N. R. <u>16</u> E. <u>1/2</u> miles <u>South</u> of <u>Pearlington</u> (distance) (direction) (nearest town)	<u>Blue Clay</u>	<u>65</u>	<u>182</u>
WELL PURPOSE: <u>Home</u> (home, irrigation, municipal, industrial)	<u>Fine Blue sd.</u>	<u>182</u>	<u>225</u>
WELL COMPLETION DATA:	<u>Blue Clay</u>	<u>225</u>	<u>237</u>
(1) diameter (inches) <u>4 1/2</u>	<u>Fine Blue sd.</u>	<u>237</u>	<u>251</u>
(2) total depth (feet) <u>452</u>	<u>Blue Clay</u>	<u>251</u>	<u>393</u>
(3) static water level (feet) <u>42</u> below top of ground.	<u>Gray coarse sd</u>	<u>393</u>	<u>452</u>
(4) casing <u>Galv.</u> <u>442</u> (material) (depth)			
<u>2"</u> if telescope see back. (size)			
(5) screen <u>10'</u> <u>442</u> (length) (depth to top)			
<u>2"</u> <u>S.S.</u> (size) (material)			
(6) pump <u>1/2</u> <u>600 G.P.M.</u> (HP) (yield gpm)			
<u>Elect</u> (type power)			
(7) electric log <u>NO</u> (yes or no)			
(organization running log)			
(8) how well bottom plugged <u>Shoe</u>			
DRILLERS REMARKS:			


CODED

JAN 26 1971

MISS. BD. OF
 WATER COM.

If well telescopes please sketch and show depths.

GROUND LEVEL

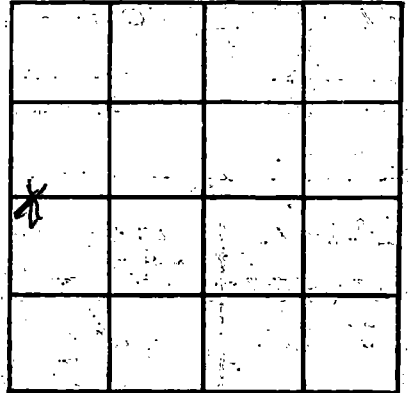

SECTION 7

Please indicate well location X.

ADDITIONAL INFORMATION

If more than one screen, show locations of each on sketch.