

MISSISSIPPI DEPARTMENT OF NATURAL RESOURCES

Bureau of Land and Water Resources

Southport Mall

P.O. Box 10631

CODED

Jackson, Mississippi 39209

WATER WELL DRILLERS LOG

HANCOCK
L 97

7-15- 19 84
date well completed

Ward Well Dlg
firm name

Hancock
county well located

LANDOWNER: Charlie m. Party
General Delivery
Reelington, ms.
(mailing/address)

description of formations encountered

from to

WELL LOCATION:
sec 37 T 9 N R 16 E
4 miles N/E of Reelington
(distance) (direction) (nearest town)

<u>Clay</u>	<u>0</u>	<u>15</u>
<u>SS</u>	<u>15</u>	<u>36</u>
<u>Clay</u>	<u>36</u>	<u>86</u>
<u>SS</u>	<u>86</u>	<u>115</u>
<u>Clay - silt</u>	<u>115</u>	<u>396</u>
<u>SS</u>	<u>396</u>	<u>458</u>
<u>Clay - silt</u>	<u>458</u>	<u>695</u>
<u>Coarse S</u>	<u>695</u>	<u>782</u>

WELL PURPOSE: None
(home, irrigation, municipal, industrial)

WELL COMPLETION DATA:

(1) diameter (inches) 2"

(2) total depth (feet) 782

(3) static water level (feet) 10 below top of ground. above

(4) casing Galv. 762
(material) (depth)

- If telescope see back.
(size)

(5) screen 20' -
(length) (depth to top)

2" S.S.
(size) (material)

(6) pump - -
(HP) (yield gpm)

-
(type power)

(7) electric log NO
(yes or no)

N/A
(organization running log)

(8) how well bottom plugged BWV

CODED

DEPT. OF NATURAL RESOURCES
BUREAU OF LAND & WATER RESOURCES


SEP - 4 1984

RECEIVED

DRILLERS REMARKS: 25 G.P.M.
6 PSI

If well telescopes please sketch and show depths.

GROUND LEVEL

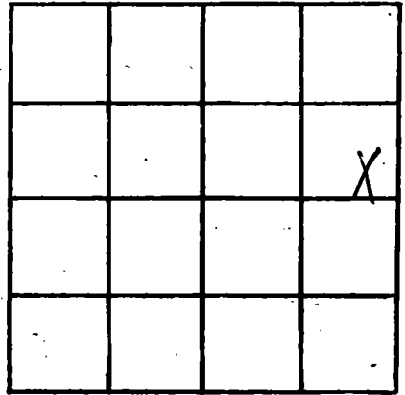

SECTION _____

Please indicate well location X.

ADDITIONAL INFORMATION

If more than one screen, show locations of each on sketch.