

MISSISSIPPI DEPARTMENT OF NATURAL RESOURCES

Bureau of Land and Water Resources

Southport Mall

P.O. Box 10631

Jackson, Mississippi 39209

WATER WELL DRILLERS LOG

HANCOCK
L99
3-5-85

March 5 1985 Ward Well Dlg. Hancock
 date well completed firm name county well located

LANDOWNER: Joyce Pullman
 P.O. Box 213
 Rockington ms.
 (mailing address)

description of formations encountered	from	to
	Clay	0
sd	41	52
sd - gravel	52	74
Clay	74	92
sd	92	115

WELL LOCATION:
 ? sec. 19 T. 8 N R. 16 E
 9 S
 miles (distance) of Rockington (direction) (nearest town)

WELL PURPOSE: Home
 (home, irrigation, municipal, industrial)

WELL COMPLETION DATA:

(1) diameter (inches) 2"

(2) total depth (feet) 115'

(3) static water level (feet) 10 below top of ground.

(4) casing PVC, 105' (material) (depth)
 (size) if telescope see back.

(5) screen 10' (length) (depth to top)
 2" PVC (size) (material)

(6) pump owner (HP) (yield gpm)
 (type power)

(7) electric log NO (yes or no)
 N/A (organization running log)

(8) how well bottom plugged BWV


RECEIVED
 MAY 14 1985

DRILLERS REMARKS: N/A

Department of Natural Resources
 Bureau of Land & Water Resources

If well telescopes please sketch and show depths.

GROUND LEVEL

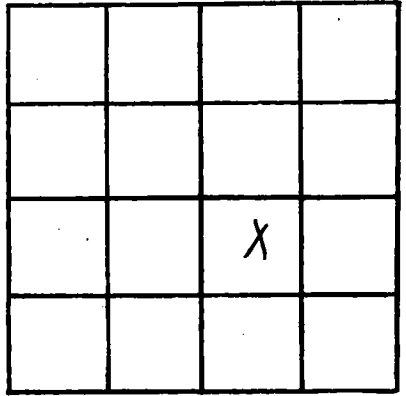

SECTION 19

Please indicate well location X.

ADDITIONAL INFORMATION

If more than one screen, show locations of each on sketch.