

MISSISSIPPI DEPARTMENT OF NATURAL RESOURCES

Bureau of Land and Water Resources

Southport Mall

P.O. Box 10631

Jackson, Mississippi 39209

WATER WELL DRILLERS LOG

CODED

Hancock
L438
10-10-85

Oct. 10 1985 Ward Well Drg. Hancock
 date well completed firm name county well located

LANDOWNER: Elizabeth B. Johnson
River Drive
Pearlington, Mrs.
 (mailing address)

description of formations encountered	from	to
Clay	0	21
sd	21	45
fin gravel - sd	45	64
Clay	64	96
sd	96	125
Clay-Silt	125	258
Fine sd	258	286
Clay-Silt	286	410
Coarse sd	410	456

WELL LOCATION:
 sec. 20 T. 9 N R. 16 E
 (distance) miles (direction) of Pearlington (nearest town)

WELL PURPOSE: Home
 (home, irrigation, municipal, industrial)

WELL COMPLETION DATA:

(1) diameter (inches) 2"

(2) total depth (feet) 456

(3) static water level (feet) 1 ^(below) above top of ground.

(4) casing PVC, 436,
 (material) (depth)

2" If telescope see back.
 (size)

(5) screen 20', -
 (length) (depth to top)

2", PVC
 (size) (material)

(6) pump owner, -
 (HP) (yield gpm)

-
 (type power)

(7) electric log NO
 (yes or no)

N/A
 (organization running log)

(8) how well bottom plugged BWD

DRILLERS REMARKS: N/A


RECEIVED

NOV 20 1985

Department of Natural Resources
 Bureau of Land & Water Resources

If well telescopes please sketch and show depths.

GROUND LEVEL

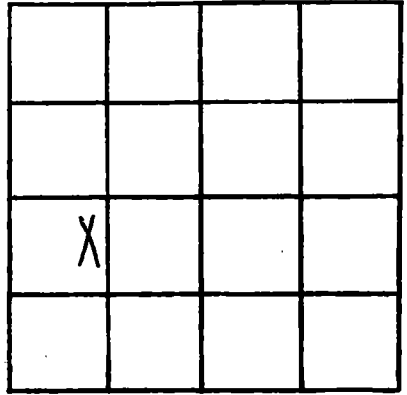

SECTION 20

Please indicate well location X.

ADDITIONAL INFORMATION

If more than one screen, show locations of each on sketch.