


HAUcock

MISSISSIPPI BOARD OF WATER COMMISSIONERS

L68

4-5-65

WATER WELL DRILLERS LOG

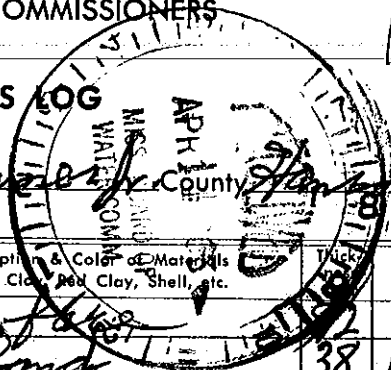

K

Date: 4-5, 1965, Driller: D. K. Summers, County: Hancock

(Name)

(1) Owner of Land: W. A. Dodge

(Name)

Pearlington Miss. SUB DIV.

(Address)

(2) Location: 1/4, 1/4, Sec. 9 R. 16

miles

(distance)

(direction)

of (Nearest Town)

(3) Topography: Hilly

(Hilly)

(Flat)

(Level)

(4) Purpose of Well: Domestic

(Domestic Irrigation, Municipal, Industrial, Other)

| Description & Color of Materials Sand, Clay, Red Clay, Shell, etc. | Thickness | Depth Feet |
|---|-----------|---------------|
| Loose sand | 2 | 92 |
| Loose sand | 38 | 130 |
| Shale | 15 | 145 |
| Loose sand | 26 | 171 |
| Shale | 104 | 275 |
| Loose sand & shale bits | 70 | 345 |
| Shale | 46 | 391 |
| Loose sand | 105 | 496 |
| Shale | 41 | 537 |
| Loose sand | 38 | 575 |
| Shale | 825 | 1400 |
| Shale & sand shale | 187 | 1587 |
| Shale | 321 | 1908 |
| Sand | 130 | 2038 |

Information upon completion of well:

(1) Diameter: 2" inches.

(2) Total Depth: 2015 feet.

(3) Water Level: 45 lb. pressure foot below top of ground.

(4) Cased to: 1995, Size: 2"

(5) Screen: Size: 2", Length: 20ft.

(6) Were any formations sealed against pollution? yes, no.

If YES depth of formation

Why

Drillers Remarks:

Well No.

(Use Back Side)

Mail this copy to Board of Water Commissioners 429 Miss. St. Jackson, Miss.