

HANCOCK

MISSISSIPPI BOARD OF WATER COMMISSIONERS

E LOG # 90


L69  
3-1-65

WATER WELL DRILLERS LOG

CODED

Date: 3-1-1965, Driller: D.K. Summers, County Hancock  
(Oak Harbor Subdv) (Name)

(1) Owner of Land	Description & Color of Materials Sand, Clay, Red Clay, Shell, etc.	Thick- ness Feet	Depth Feet
Deakno Utilities, Inc. (Name) Jackson, Mississippi 90. BOX 8127 (Address)	Surface	34	34
(2) Location: 1/4, 1/4, Sec. 20 T. 9. R. 16	Sand	26	60
1/2 miles E of Pearlman	Shell	20	80
(3) Topography: Hills	Sand	40	120
(4) Purpose of Well: Municipal	Shell	20	140
(Domestic Irrigation)	Sand	30	170
(Municipal, Industrial, Other)	Shell	170	340
Information upon completion of well:	Sand	16	356
(1) Diameter: 8" inches.	Shell	50	406
(2) Total Depth: 209 feet.	Sand	10	416
(3) Water Level: 44 1/2 ft. pressure	Shell	84	500
(4) Cased to: 1930 ft. Size 6"	Sand	138	638
(5) Screen: Size 6", Length 60 ft.	Shell	66	704
(6) Were any formations sealed against pollution?	Sand	12	716
If YES depth of formation: 20 ft.	Shell	76	792
Why: Board of Health, Reg. 10	Sand	29	814
Drillers Remarks: Well flows	Shell	46	860
888 Gallons per Minute	Sand	57	917
	Shell	679	1596
	Sand	52	1648
	Shell	236	1884
	Sand	106	1990

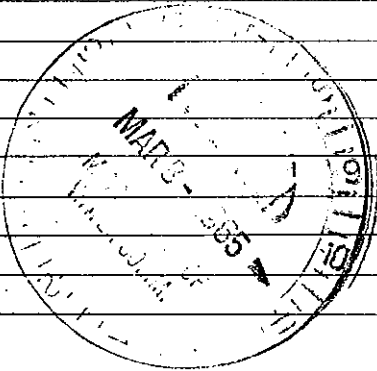

(Use Back Side)

Well No.

Mail this copy to Board of Water Commissioners 429 Miss. St. Jackson, Miss.