

L 2000

3-1-63

WATER WELL DRILLERS LOG

L

Date: 3-1, 1963, Driller: Sutter Well Works County Hancock

(Name)

(1) Owner of Land: J. E. Aluka
(Name)
Pearlington, Miss.
(Address)

Description & Color of Materials Sand, Clay, Red Clay, Shell, etc.	Thick- ness Feet	Depth Feet
<u>Clay - sand streaks</u>	<u>88</u>	<u>88</u>
<u>sand</u>	<u>20</u>	<u>108</u>

(2) Location: NE 1/4, NE 1/4, Sec. 28 T9SR16, 00W
1 miles S of Pearlington
(distance) (direction) (Nearest Town)

(3) Topography: flat
(Hilly) (Flat) (Level)

(4) Purpose of Well: domestic home
(Domestic Irrigation
Municipal, Industrial, Other)

Information upon completion of well:

(1) Diameter 2 inches.

(2) Total Depth 108 feet.

(3) Water Level 2 feet below top of ground.

(4) Cased to 103 103 apk, Size 2"


(5) Screen: Size 2", Length 5'

(6) Were any formations sealed against pollution?
yes, no.

If YES depth of formation _____

Why _____

Drillers Remarks: _____

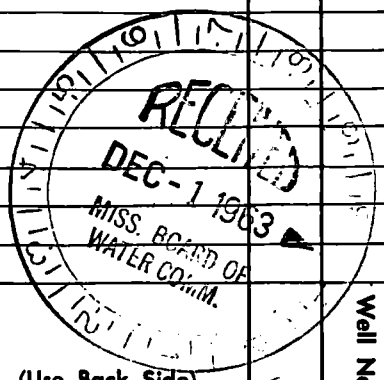

(Use Back Side)

Well No.

1880

1880

