

HANCOCK MISSISSIPPI BOARD OF WATER COMMISSIONERS

L 2001

7-14-60

WATER WELL DRILLERS LOG

(?)

Date: 7-14, 19 60, Driller: Sutter Well Co County Hancock
 (Name)

(1) Owner of Land: Shawn Vignerie
 (Name)
Pearlington Miss.
 (Address) T.D.W.D.

(2) Location: 1/4, 1/4, Sec. 28 T. 9S R. 4E
 _____ miles _____ of _____
 (distance) (direction) (Nearest Town)

(3) Topography: flat
 (Hilly) (Flat) (Level)

(4) Purpose of Well: domestic
 (Domestic Irrigation
 Municipal, Industrial, Other)

Description & Color of Materials Sand, Clay, Red Clay, Shell, etc.	Thick- ness Feet	Depth Feet
<u>clay</u>	<u>20</u>	<u>20</u>
<u>surface sand</u>	<u>60</u>	<u>80</u>
<u>clay with sand</u>		
<u>streaks</u>	<u>326</u>	<u>406</u>
<u>sand</u>	<u>80</u>	<u>486</u>

Information upon completion of well:

(1) Diameter 2 1/2 inches.

(2) Total Depth 486 feet. TYPE FLOW

(3) Water Level 12 feet below top of ground. 470 above flow

(4) Cased all, Size 2 1/2"


(5) Screen: Size 2", Length 16'

(6) Were any formations sealed against pollution?
 _____ yes, no.

If YES depth of formation _____

Why _____

Drillers Remarks: _____

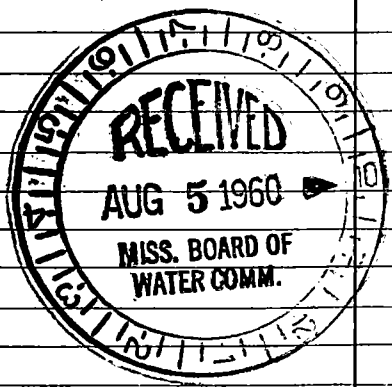

(Use Back Side)

Well No.

