

HANCOCK MISSISSIPPI BOARD OF WATER COMMISSIONERS

L 2002

8-2-60

WATER WELL DRILLERS LOG



Date: 8-2, 1960, Driller: Sutter Well Works County Hancock
 (Name)

(1) Owner of Land: Mrs. A. S. Duncy
 (Name)
Logtown, Miss.
 (Address)

(2) Location: 1/4, 1/4, Sec. 28 T. 9S. R. 16E
8 miles, of _____, of _____
 (distance) (direction) (Nearest Town)

(3) Topography: Flat
 (Hilly) (Flat) (Level)

(4) Purpose of Well: domestic home
 (Domestic Irrigation, Municipal, Industrial, Other)

Description & Color of Materials Sand, Clay, Red Clay, Shell, etc.	Thick- ness Feet	Depth Feet
<u>Clay</u>	<u>80</u>	<u>80</u>
<u>sand</u>	<u>50</u>	<u>130</u>
<u>Clay - sand streaks</u>	<u>600</u>	<u>730</u>
<u>sand</u>	<u>78</u>	<u>808</u>
<u>Clay</u>	<u>368</u>	<u>1176</u>
<u>sand</u>	<u>22</u>	<u>1198</u>

Information upon completion of well:

(1) Diameter 4 inches. 795
20
775


(2) Total Depth 795 feet. Flow

(3) Water Level 4 feet below top of ground. above

(4) Cased to all, Size 4"

(5) Screen: Size 4", Length 20'

(6) Were any formations sealed against pollution?
 _____ yes, no.

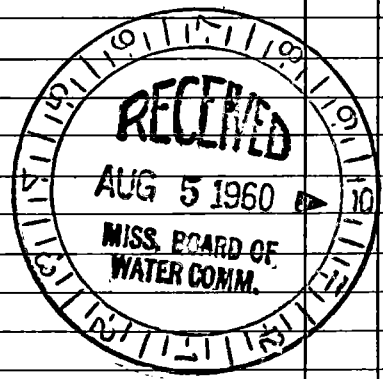

If YES depth of formation _____

Why _____

Drillers Remarks: 1200' depth in-
sufficient sand. Well
Completed ~~795~~ 795'

(Use Back Side)

Well No.

Handwritten text at the top of the page, possibly a title or header, which is mostly illegible due to the high level of noise and contrast in the scan.

The table is a large grid structure, likely a ledger or data table. It features a prominent vertical line on the left side, creating a narrow column. The rest of the table is divided into several columns of varying widths. The rows are separated by horizontal lines. Due to the extreme contrast and noise in the image, the text within the cells is completely illegible. The table appears to be mostly empty or contains very faint, unreadable data.