

HANCOCK

L 2005

WATER WELL DRILLERS LOG

5-1-61

L 3

Hancock P.R.

Date: 5-1, 1961, Driller: Quick & Fine County P.R. (Name)

(1) Owner of Land: Earl J. DeFon
 (Name)
Pearlington Miss
 (Address)

(2) Location: 1/4, 1/4, Sec. 2 T. 95 R. 16
 _____ miles _____ of _____
 (distance) (direction) (Nearest Town)

(3) Topography: _____
 (Hilly) (Flat) (Level)

(4) Purpose of Well: _____
 (Domestic Irrigation
 Municipal, Industrial, Other)

Description & Color of Materials Sand, Clay, Red Clay, Shell, etc.	Thick- ness Feet	Depth Feet
Built up land.	0	5
Surface clay.	5	25
Surface sand	25	35
Blue Clay	35	85
Good Sand	85	111

Information upon completion of well:

(1) Diameter 2 inches.


(2) Total Depth 111 feet.

(3) Water Level 5 feet below top of ground.

(4) Cased to 106, Size _____.

(5) Screen: Size 2", Length 5'.


(6) Were any formations sealed against pollution?
 _____ yes, X no.

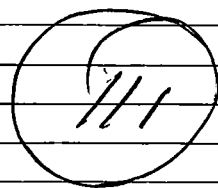

If YES depth of formation _____

Why _____

Drillers Remarks: Good well.

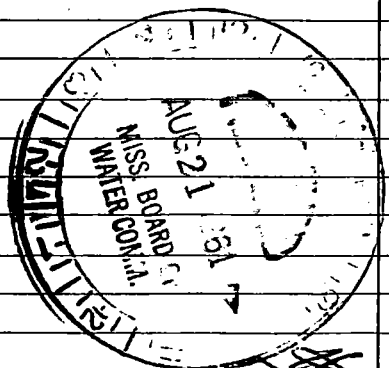

(Use Back Side)

Well No.

