

MISSISSIPPI BOARD OF WATER COMMISSIONERS

Hancock
L 2011
10-1-62

WATER WELL DRILLERS LOG

Date: 10-1, 1962, Driller: Sutter Well Works County Hancock
(Name)

	Description & Color of Materials Sand, Clay, Red Clay, Shell, etc.	Thick- ness Feet	Depth Feet
(1) Owner of Land: <u>O.L. Larson</u> (Name) <u>Pearlington Miss.</u> (Address)	<u>Sand</u>	<u>10</u>	<u>10</u>
(2) Location: <u>NE 1/4, NE 1/4, Sec. 20 T9S R16, W</u> <u>1/4</u> miles <u>W</u> , of <u>Pearlington</u> (distance) (direction) (Nearest Town)	<u>Clay</u>	<u>22</u>	<u>32</u>
(3) Topography: <u>flat</u> (Hilly) (Flat) (Level)	<u>Sand</u>	<u>17</u>	<u>49</u>
(4) Purpose of Well: <u>domestic Home</u> (Domestic Irrigation Municipal, Industrial, Other)	<u>Clay</u>	<u>31</u>	<u>80</u>
	<u>Sand</u>	<u>30</u>	<u>110</u>


Information upon completion of well:

- (1) Diameter 2 inches.
- (2) Total Depth 110 feet.
- (3) Water Level 1 feet above ^{FLGW} below top of ground.
- (4) Cased to app, Size 2".
- (5) Screen: Size 2", Length 5'.
- (6) Were any formations sealed against pollution?
yes, no.

If YES depth of formation _____

Why _____

Drillers Remarks: _____

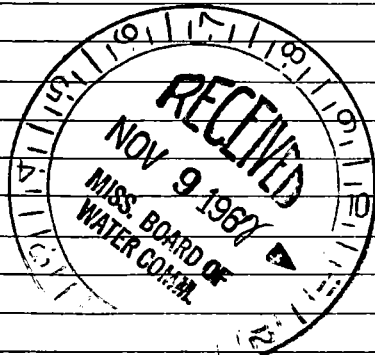

(Use Back Side)

Well No.

Handwritten notes on the left margin, including the number '1' and some illegible scribbles.

Main body of handwritten text, appearing as a list or series of notes. Some legible words include 'Total' and 'Tenth'.

Handwritten text in the lower right quadrant, possibly a summary or conclusion.

A small handwritten mark or signature at the bottom right.