

L 204

4-30-63

WATER WELL DRILLERS LOG

L

Date: 4-30, 1963, Driller: Sutter Well Works County Hancock

(1) Owner of Land: Alex Estane (Name) 2427 Eagle St. - N.O. La. (Address)

(2) Location: 1/4, 1/4, Sec. 19 T2R16W of Pearlington, (Nearest Town)

(3) Topography: flat (Hilly) (Flat) (Level)


(4) Purpose of Well: domestic (Domestic Irrigation Municipal, Industrial, Other)

Table with 3 columns: Description & Color of Materials, Thickness Feet, Depth Feet. Rows include Clay, Sand, Clay, sand, Clay-sand streaks, clay, sand.

Information upon completion of well:

- (1) Diameter 2 inches. (2) Total Depth 436 feet. (3) Water level 4 feet above flood ground. (4) Cased to all, Size 2". (5) Screen: Size 2", Length 16'. (6) Were any formations sealed against pollution? yes, no.

If YES depth of formation Why Drillers Remarks:

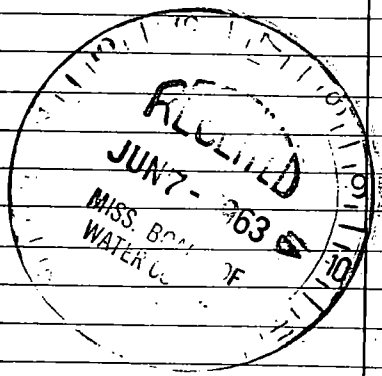

(Use Back Side)

Well No.

