

HANCOCK MISSISSIPPI BOARD OF WATER COMMISSIONERS

L 2018  
10-1-64

WATER WELL DRILLERS LOG

K

Date: 10-1, 1964, Driller: Walter Pantoni County Hancock

(Name)

(1) Owner of Land: Pentiss Kennedy  
(Name)  
Pearlington Miss  
(Address)

Description & Color of Materials  
Sand, Clay, Red Clay, Shell, etc.

Thick-  
ness  
Feet

Depth  
Feet

Pipe clay  
Sand  
Blue clay  
Grey Sand

28 0-28  
12 40  
38 78  
108

(2) Location: 1/4, 1/4, Sec. 33 T8 R16  
0 miles, of Same  
(distance) (direction) (Nearest Town)

(3) Topography: Flat  
(Hilly) (Flat) (Level)

(4) Purpose of Well: Domestic Home  
(Domestic Irrigation  
Municipal, Industrial, Other)

Information upon completion of well:

(1) Diameter 2 inches.

(2) Total Depth 108 feet.

(3) Water Level -6 feet below top of ground.

(4) Cased to 103, Size \_\_\_\_\_


(5) Screen: Size 010, Length 5'

(6) Were any formations sealed against pollution?  
\_\_\_\_\_ yes, \_\_\_\_\_ no.

If YES depth of formation \_\_\_\_\_

Why \_\_\_\_\_

Drillers Remarks: \_\_\_\_\_

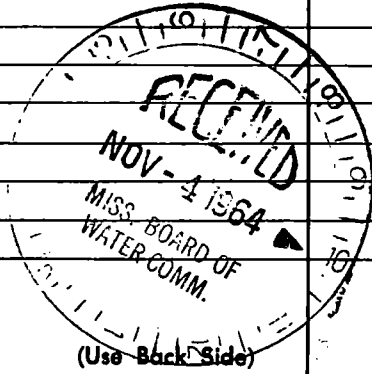

Well No.

