

**MISSISSIPPI  
BOARD OF WATER COMMISSIONERS**  
416 North State Street  
Jackson, Mississippi 39201

**WATER WELL DRILLERS LOG**

Hancock  
L 2021  
3-67

3-28  
date well completed

1967 Sutter Well Works  
firm name

Hancock  
county well located

LANDOWNER: E. VARBOROUGH

Pearlington, Miss.

(mailing address)

**WELL LOCATION:**

sec 20 T 9 N R 16 E  
S W  
1 miles E of Pearlington  
(distance) (direction) (nearest town)

WELL PURPOSE: home  
(home, irrigation, municipal, industrial)

**WELL COMPLETION DATA:**


- (1) diameter (inches) 2
- (2) total depth (feet) 171
- (3) static water level (feet) 5 below above top of ground.
- (4) casing galv., 166'  
(material) (depth)
- if telescope see back.  
(size)
- (5) screen 5', 166'  
(length) (depth to top)
- 2", stainless steel  
(size) (material)
- (6) pump 1 1/2, 15  
(HP) (yield gpm)
- elec.  
(type power)
- (7) electric log no  
(yes or no)
- (organization running log)
- (8) how well bottom plugged BPU valve

description of formations encountered

from to

<u>mottled clay</u>	<u>0</u>	<u>8</u>
<u>sand</u>	<u>8</u>	<u>19</u>
<u>clay</u>	<u>19</u>	<u>38</u>
<u>sand &amp; gravel</u>	<u>38</u>	<u>68</u>
<u>clay</u>	<u>68</u>	<u>76</u>
<u>sand &amp; gravel</u>	<u>76</u>	<u>100</u>
<u>clay</u>	<u>100</u>	<u>149</u>
<u>sand</u>	<u>149</u>	<u>171</u>

DRILLERS REMARKS:

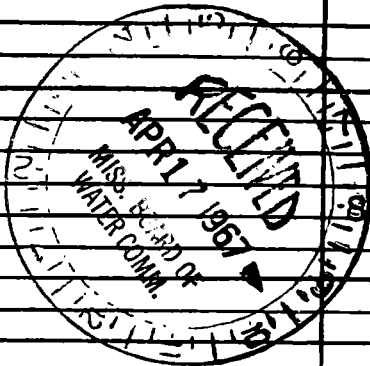

If well telescopes please sketch and show depths.

GROUND LEVEL

X			

SECTION 20

Please indicate well location X.

ADDITIONAL INFORMATION

If more than one screen, show locations of each on sketch.