

**MISSISSIPPI
BOARD OF WATER COMMISSIONERS**
416 North State Street
Jackson, Mississippi 39201

WATER WELL DRILLERS LOG

date well completed 3-29 1967 firm name Sutter Well Works county well located Hancock

LANDOWNER: Emelda Heggelberger
Pearlington, Miss.

(mailing address)


WELL LOCATION:
sec 20 T 9 R 16
S W
1 miles E Pearlington
(distance) (direction) (nearest town)

WELL PURPOSE: home
(home, irrigation, municipal, industrial)

WELL COMPLETION DATA:

- (1) diameter (inches) 2
- (2) total depth (feet) 172
- (3) static water level (feet) 5 below above top of ground.
- (4) casing galv. (material), 167' (depth)
- (size) If telescope see back.
- (5) screen 5' (length), 167' (depth to top)
2" (size), stainless steel (material)
- (6) pump unknown (HP), 20 (yield gpm)
- (type power)
- (7) electric log no. (yes or no)
- (organization running log)
- (8) how well bottom plugged B.P. Valves


Description of formations encountered	from	to
Clay	0	18
Sand	18	32
Clay	32	58
Sand & gravel	58	101
Clay	101	141
Sand	141	172

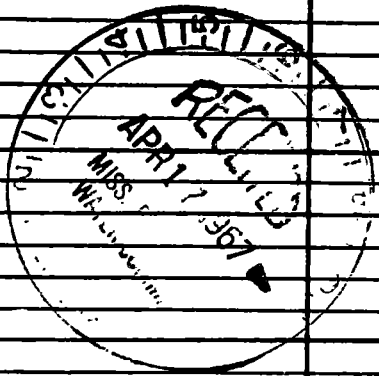

DRILLERS REMARKS:

If well telescopes please sketch and show depths.

GROUND LEVEL

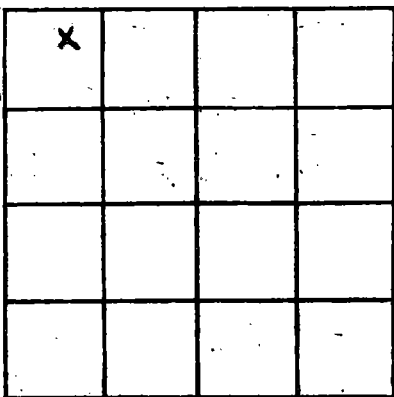

X			

SECTION 20

Please indicate well location X.

ADDITIONAL INFORMATION

If more than one screen, show locations of each on sketch.