

Hancock
 L 2093
 4-67

MISSISSIPPI
 BOARD OF WATER COMMISSIONERS
 416 North State Street
 Jackson, Mississippi 39201

WATER WELL DRILLERS LOG

4-3 1967 date well completed
 Little Well Works firm name
 Hancock county well located

LANDOWNER: W. Holder
 Pearlinton Miss.

(mailing address)
 WELL LOCATION:
 sec 28 T 9 R 16 S W
 1 miles S of Pearlinton
 (distance) (direction) (nearest town)


WELL PURPOSE: home
 (home, irrigation, municipal, industrial)

WELL COMPLETION DATA:

- (1) diameter (inches) 2
- (2) total depth (feet) 113
- (3) static water level (feet) 7 below top of ground.
- (4) casing galv. 108 (material) (depth)
- (size) If telescope see back.
- (5) screen 5' 108 (length) (depth to top)
- 2" stainless steel (size) (material)
- (6) pump 1/2 20 (HP) (yield gpm)
- elec (type power)
- (7) electric log No (yes or no)
- (organization running log)
- (8) how well bottom plugged BP Valve

description of formations encountered	from	to
White Clay	0	18
Clay, sand streaks	18	60
lost circulation	60	64
fine sand, mud	64	79
lost circulation	79	84
Clay	84	92
sand	92	113

DRILLERS REMARKS:

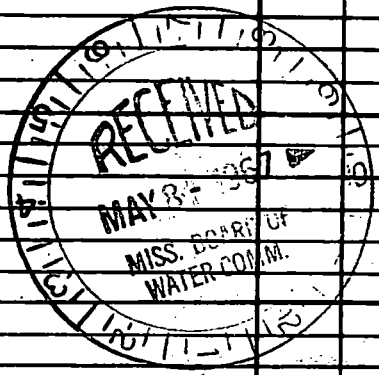

If well telescopes please sketch and show depths.

GROUND LEVEL

81
82
83
84
85
86
87
88
89
90

100 5' 10"
101 5' 10"
102 5' 10"
103 5' 10"
104 5' 10"
105 5' 10"
106 5' 10"
107 5' 10"
108 5' 10"
109 5' 10"
110 5' 10"

↑
N

100	101	X	102
103	104	105	106
107	108	109	110
111	112	113	114

SECTION 28

Please indicate well location X.

ADDITIONAL INFORMATION

115
116
117
If more than one screen, show locations of each on sketch.