

Hancock  
 L 2024  
 4-67

MISSISSIPPI  
 BOARD OF WATER COMMISSIONERS  
 416 North State Street  
 Jackson, Mississippi 39201

WATER WELL DRILLERS LOG

4-14 1967 Sutter Well Works Hancock  
 date well completed firm name county well located

LANDOWNER: Std. dredging  
 Box 8092 Gentilly Sta.  
 New Orleans, La.  
 (mailing address)


description of formations encountered	from	to
Clay	0	16
Sand	16	68
Clay	68	190
Sand	190	230
Clay	230	395
Sand	395	588
Clay	588	764
Sand	764	810

WELL LOCATION:  
 sec. 17 T. 9 S. R. 16 E. W.  
 1 miles N of Pearlridge  
 (distance) (direction) (nearest town)

WELL PURPOSE: Home  
 (home, irrigation, municipal, industrial)


- WELL COMPLETION DATA:
- (1) diameter (inches) 2
  - (2) total depth (feet) 810
  - (3) static water level (feet) 15 below above top of ground
  - (4) casing galv. 790'  
 (material) (depth)  
 (size) If telescope see back.
  - (5) screen 20' 790'  
 (length) (depth to top)  
 2" stainless steel  
 (size) (material)
  - (6) pump (HP) (yield gpm)  
 (type power)
  - (7) electric log No (yes or no)  
 (organization running log)
  - (8) how well bottom plugged B.P. Valve

DRILLERS REMARKS:

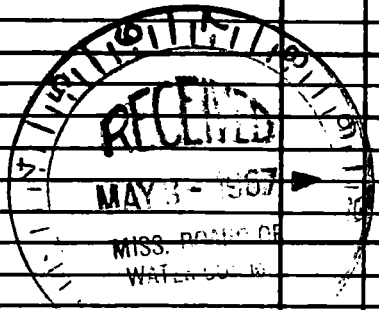

If well telescopes please sketch and show depths.

GROUND LEVEL

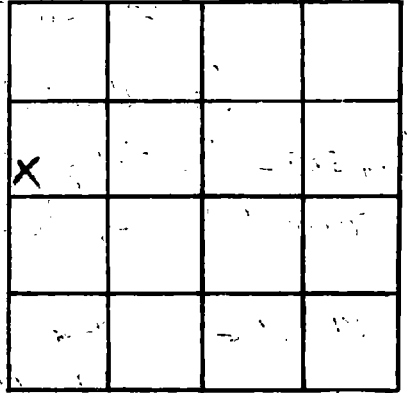

SECTION 17

Please indicate well location X.

ADDITIONAL INFORMATION

Lined area for additional information.

If more than one screen, show locations of each on sketch.