

Hancock
L 2296
6-67

MISSISSIPPI
 BOARD OF WATER COMMISSIONERS
 416 North State Street
 Jackson, Mississippi 39201

WATER WELL DRILLERS LOG

6-8 1967 Sutter Well Works Hancock
 date well completed firm name county well located

LANDOWNER: BELDEN WATTS

description of formations encountered

from to

PICAYUNE
MISS.
 (mailing address)

Clay
sand
Clay
sand
Clay
sand

0 18
18 37
37 60
60 70
70 101
101 114

WELL LOCATION:

sec 28 T 9 N R 16 E
1 miles S of Pearlington
 (distance) (direction) (nearest town)

WELL PURPOSE: home
 (home, irrigation, municipal, industrial)


WELL COMPLETION DATA:

- (1) diameter (inches) 2
- (2) total depth (feet) 114
- (3) static water level (feet) 2' below above top of ground.
- (4) casing galv. 109'
 (material) (depth)
2" if telescope see back.
 (size)
- (5) screen 5' 109'
 (length) (depth to top)
2" stainless steel
 (size) (material)
- (6) pump unknown
 (HP) (yield gpm)

(7) electric log no
 (yes or no)

(organization running log)


(8) how well bottom plugged BP Value

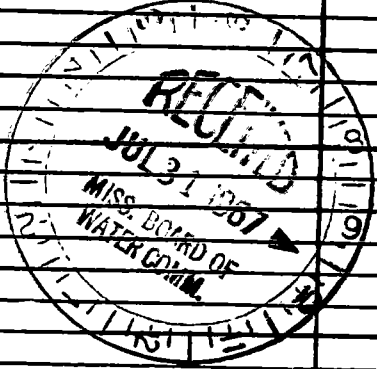

DRILLERS REMARKS:

If well telescopes please sketch and show depths.

GROUND LEVEL

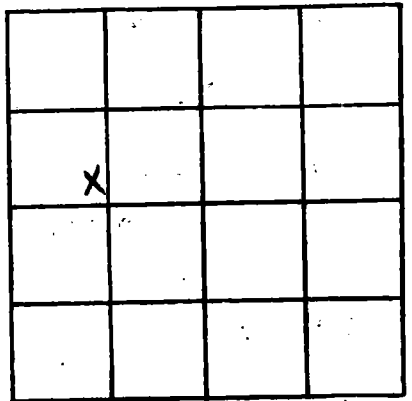

SECTION 28

Please indicate well location X.

ADDITIONAL INFORMATION

If more than one screen, show locations of each on sketch.