

Hancock  
L2027  
6-67

MISSISSIPPI  
BOARD OF WATER COMMISSIONERS  
416 North State Street  
Jackson, Mississippi 39201

WATER WELL DRILLERS LOG

6-8 1967 date well completed  
Lutter Well Works firm name  
Hancock county well located

LANDOWNER: BELDEN WATTS

Picayune,  
Miss.  
(mailing address)

description of formations  
encountered

from to

Gravel	0	65
Clay	65	98
Sand	98	110

WELL LOCATION:

sec. 28 T. 9 S. R. 16 E.  
1 miles S of Pearlinton  
(distance) (direction) (nearest town)

WELL PURPOSE: home  
(home, irrigation, municipal, industrial)

WELL COMPLETION DATA:


- (1) diameter (inches) 2
- (2) total depth (feet) 110
- (3) static water level (feet) 2 below top of ground.
- (4) casing (material) Galv., (depth) 105'  
2" (size) if telescope see back.
- (5) screen (length) 5', (depth to top) 105'  
2" (size), Stainless Steel (material)
- (6) pump Unknown (HP) (yield gpm)

(type power)

(7) electric log no (yes or no)

(organization running log)

(8) how well bottom plugged B.P. Value

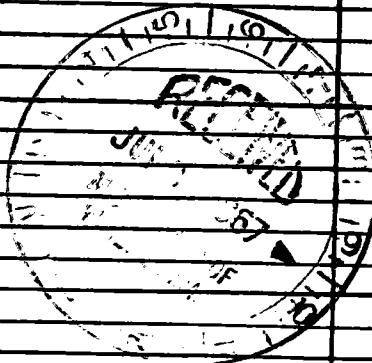

DRILLERS REMARKS:

If well telescopes please sketch and show depths.

GROUND LEVEL



X			

SECTION 28

Please indicate well location X.

ADDITIONAL INFORMATION

If more than one screen, show locations of each on sketch.