

HANCOCK
L 2029
2-68

MISSISSIPPI
BOARD OF WATER COMMISSIONERS
416 North State Street
Jackson, Mississippi 39201

WATER WELL DRILLERS LOG

2-16 1968 date well completed Lutter Well Works firm name Hancock county well located


LANDOWNER: Earl Anderson
Pearlington
Miss.
(mailing address)

WELL LOCATION:
sec. 16 T 9 S R. 16 W
_____ miles _____ of Pearlington
(distance) (direction) (nearest town)

WELL PURPOSE: Home
(home, irrigation, municipal, industrial)

- WELL COMPLETION DATA:
- (1) diameter (inches) 2
 - (2) total depth (feet) 110
 - (3) static water level (feet) 9 below above top of ground.
 - (4) casing Galv. 105'
(material) (depth)
2" If telescope see back.
(size)
 - (5) screen 5' 105'
(length) (depth to top)
2" Stainless steel
(size) (material)
 - (6) pump Unknown
(HP) (yield gpm)
(type power)
 - (7) electric log no
(yes or no)
(organization running log)
 - (8) how well bottom plugged BP Valve

description of formations encountered	from to	
<u>Clay</u>	<u>0</u>	<u>22</u>
<u>sandy clay</u>	<u>22</u>	<u>41</u>
<u>sand + gravel</u>	<u>41</u>	<u>70</u>
<u>Clay</u>	<u>70</u>	<u>85</u>
<u>sand</u>	<u>85</u>	<u>110</u>

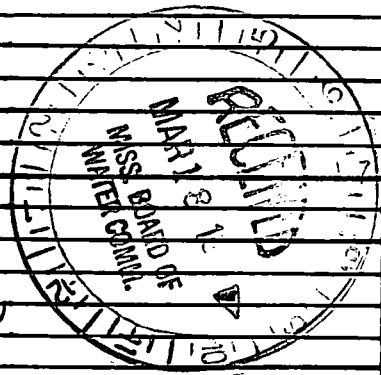

DRILLERS REMARKS:

If well telescopes please sketch and show depths.

GROUND LEVEL

X			

SECTION 16

Please indicate well location X.

ADDITIONAL INFORMATION

If more than one screen, show locations of each on sketch.