

CODED

MISSISSIPPI
BOARD OF WATER COMMISSIONERS
416 North State Street
Jackson, Mississippi 39201

CODED

WATER WELL DRILLERS LOG

Hancock
L2032
2-69

Feb. 6 1969 FAURE WELLWORKS HANCOCK CO.
date well completed firm name county well located

LANDOWNER: MARY HARRIS
PEARLINGTON
MISSISSIPPI
(mailing address)

description of formations encountered	from	to
RED CLAY	0	10
BLUE CLAY	10	21
BLUE CLAY	21	42
BLUE CLAY & SHELLS	42	63
BLUE CLAY & SAND	63	94
9 RIVLE LAST 10 FT.		

WELL LOCATION:
sec 19 T8S N R16W E
miles 17 of Pearlington
(distance) (direction) (nearest town)

WELL PURPOSE: HOME
(home, irrigation, municipal, industrial)

WELL COMPLETION DATA: FEB 6.

- (1) diameter (inches) 1 1/4 1.25
- (2) total depth (feet) 94
- (3) static water level (feet) 7 below top of ground
- (4) casing 4" pipe (material) (depth)
- 1 1/4 (size) If telescope see back.
- (5) screen 5-FT. 84' (length) (depth to top)
- 1 1/2" (size) Bars (material)
- (6) pump Custom installed (HP) (yield gpm)
(type power)
- (7) electric log NO (yes or no)
(organization running log)
- (8) how well bottom plugged *pen*


CODED

*Pen
2/10/69*

DRILLERS REMARKS:

If well telescopes please sketch and show depths.

GROUND LEVEL

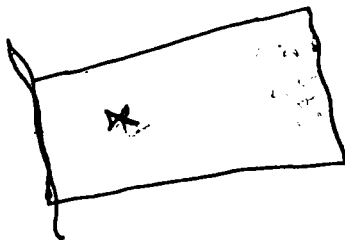

	X		

SECTION _____

Please indicate well location X.

ADDITIONAL INFORMATION

If more than one screen,
show locations of each on sketch.