

HANCOCK
L 2033
2-23-77

MISSISSIPPI
 BOARD OF WATER COMMISSIONERS
 416 North State Street
 Jackson, Mississippi 39201

WATER WELL DRILLERS LOG

2-23- 1977 Woodwell Drilling Hancock
 date well completed firm name county well located

LANDOWNER: <u>Flower Products</u> <u>Sadner St.</u> <u>Lake shore, miss.</u> (mailing address)	description of formations encountered	from	to
	<u>Top Soil - clay</u>	<u>0</u>	<u>22</u>
	<u>sd</u>	<u>22</u>	<u>35</u>
	<u>clay -</u>	<u>35</u>	<u>67</u>
	<u>clay - shell</u>	<u>67</u>	<u>95</u>
	<u>sd</u>	<u>95</u>	<u>115</u>
	<u>clay - silt</u>	<u>115</u>	<u>220</u>
	<u>sd</u>	<u>220</u>	<u>226</u>
	<u>clay - silt</u>	<u>226</u>	<u>237</u>
	<u>sd</u>	<u>237</u>	<u>270</u>
WELL LOCATION: sec. <u>24</u> T <u>9</u> N R <u>16</u> E <u>14</u> miles <u>W</u> of <u>B.S.L.</u> (distance) (direction) (nearest town)			
WELL PURPOSE: <u>Home</u> (home, irrigation, municipal, industrial)			
WELL COMPLETION DATA:			
(1) diameter (inches) <u>2"</u>			
(2) total depth (feet) <u>270</u>			
(3) static water level (feet) <u>4</u> ^{below} _{above} top of ground.			
(4) casing <u>PVC</u> , <u>260</u> , (material) (depth)			
<u>-</u> if telescope see back. (size)			
(5) screen <u>10'</u> , <u>-</u> (length) (depth to top)			
<u>2"</u> , <u>PVC</u> (size) (material)			
(6) pump <u>1/2</u> , <u>8</u> (HP) (yield gpm)			
<u>Elec.</u> (type power)			
(7) electric log <u>NO</u> (yes or no)			
<u>N/A</u> (organization running log)			
(8) how well bottom plugged <u>BWU</u>			
DRILLERS REMARKS: <u>N/A</u>			


RECEIVED

MAR 24 1977

SS. BD. OF WATER COMM.

If well telescopes please sketch and show depths.

GROUND LEVEL

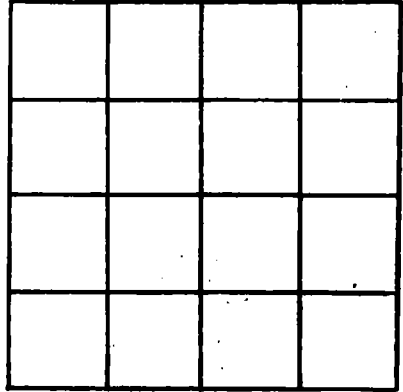

SECTION 24

Please indicate well location X.

ADDITIONAL INFORMATION

If more than one screen, show locations of each on sketch.