

**HANCOCK**  
 L 25 38  
 7-8-80

MISSISSIPPI  
 BOARD OF WATER COMMISSIONERS  
 416 North State Street  
 Jackson, Mississippi 39201

WATER WELL DRILLERS LOG

July 8 1980 Duncan Well Drilling Hancock  
 date well completed firm name county well located

LANDOWNER: Joe Vance Jr  
General Del.  
Leesburg, Mo.  
 (mailing address)

description of formations encountered	from	to
<u>Clay</u>	<u>0</u>	<u>40</u>
<u>Sand</u>	<u>40</u>	<u>95</u>

WELL LOCATION:  
 sec. 19 T. 9 N. R. 16 E.  
1 miles S.E. of Leesburg  
 (distance) (direction) (nearest town)

WELL PURPOSE: Home  
 (home, irrigation, municipal, industrial)

WELL COMPLETION DATA:

(1) diameter (inches) 2"

(2) total depth (feet) 95 ft.

(3) static water level (feet) 8' below above  
 top of ground.

(4) casing PVC, 95 ft.  
 (material) (depth)

       If telescope see back.  
 (size)

(5) screen 10', 85'  
 (length) (depth to top)

2", PVC  
 (size) (material)

(6) pump 1/2, 10  
 (HP) (yield gpm)

electric  
 (type power)

(7) electric log \_\_\_\_\_  
 (yes or no)

\_\_\_\_\_  
 (organization running log)

(8) how well bottom plugged Sand  
Shut

DRILLERS REMARKS:  
 \_\_\_\_\_  
 \_\_\_\_\_  
 \_\_\_\_\_


DEPT. OF NATURAL RESOURCES  
 BUREAU OF LAND & WATER RESOURCES

SEP 22 1980

RECEIVED

If well telescopes please sketch and show depths.

GROUND LEVEL

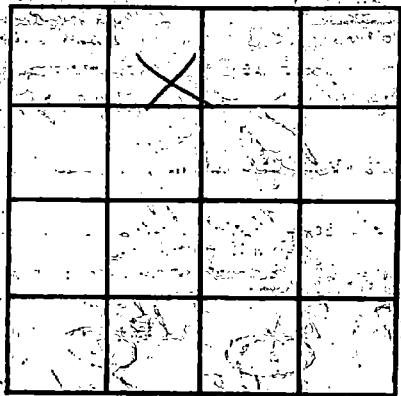

SECTION 19

Please indicate well location X.

**ADDITIONAL INFORMATION**

Multiple horizontal lines for writing additional information.

If more than one screen, show locations of each on sketch.