

MISSISSIPPI DEPARTMENT OF NATURAL RESOURCES

Bureau of Land and Water Resources

Southport Mall

P.O. Box 10631

Jackson, Mississippi 39209

WATER WELL DRILLERS LOG

Hancock
L 2040

7-21-1980
date well completed

80 Wardwell Dlg.
firm name

Hancock
county well located

LANDOWNER: Thomas J. Mayner

description of formations encountered

from to

Rt. 2, Box 532

top soil - clay

0 18

Bay St. Boris, ms.
(mailing address)

clay - shell
coral ss

18 45

45 96

96 126

WELL LOCATION:

sec 7 T 9 N R 14 E
Section 5 miles west of Wardwell
(distance) (direction) (nearest town)

WELL PURPOSE: None
(home, irrigation, municipal, industrial)

WELL COMPLETION DATA:

(1) diameter (inches) 2"

(2) total depth (feet) 126

(3) static water level (feet) 10 below above top of ground.

(4) casing PVC 1.16
(material) (depth)

(size) If telescope see back.

(5) screen 10' 1.16
(length) (depth to top)

2" PVC
(size) (material)

(6) pump Ormer ---
(HP) (yield gpm)

(type power)

(7) electric log NO
(yes or no)

(organization running log) N/A

(8) how well bottom plugged BWV

DRILLERS REMARKS: N/A


DEPT. OF NATURAL RESOURCES
BUREAU OF LAND & WATER RESOURCES

AUG 21 1980

RECEIVED

If well telescopes please sketch and show depths.

GROUND LEVEL

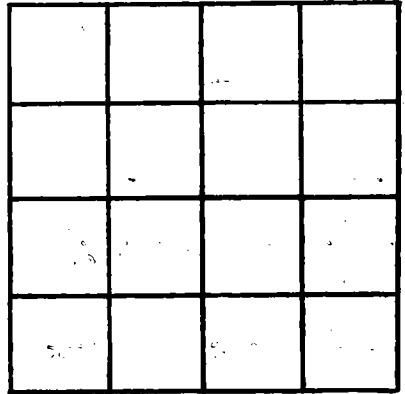

SECTION 2

Please indicate well location X.

ADDITIONAL INFORMATION

If more than one screen, show locations of each on sketch.