

MISSISSIPPI DEPARTMENT OF NATURAL RESOURCES

Bureau of Land and Water Resources

Southport Mall

P.O. Box 10631

Jackson, Mississippi 39209

WATER WELL DRILLERS LOG

HANCOCK  
L2042  
8-4-80

8-4-

date well completed

1980 Ward Well Dr.

firm name

Hancock

county well located

LANDOWNER: Warren Mennis

description of formations encountered

from

to

P.O. Box 227

Top Soil - clay

0 21

Sabe Shae, Miss.

SD

21 42

(mailing address)

clay - shell

42 97

WELL LOCATION:

sec. 22 T. 9 N. R. 14 E. 16

clay

97 110

Belle Isle of Wald.

Reaper level - SD

110 148

(distance) (direction) (nearest town)

clay - silt

148 165

WELL PURPOSE: Home

(home, irrigation, municipal, industrial)

coarse SD

165 294

WELL COMPLETION DATA:

(1) diameter (inches) 2"

(2) total depth (feet) 335

(3) static water level (feet) 10 below above top of ground.

(4) casing PVC, 325  
 (material) (depth)

(size) If telescope see back.

(5) screen 10', -325  
 (length) (depth to top)

2", PVC  
 (size) (material)

(6) pump miner  
 (HP) (yield gpm)

(type power)

(7) electric log NO  
 (yes or no)

N/A  
 (organization running log)

(8) how well bottom plugged B.W.V.

DRILLERS REMARKS: N/A


DEPT. OF NATURAL RESOURCES  
 BUREAU OF LAND & WATER RESOURCES

AUG 21 1980

RECEIVED

If well telescopes please sketch and show depths.

GROUND LEVEL

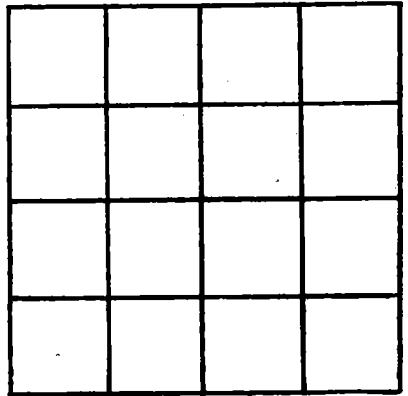

SECTION 27

Please indicate well location X.

ADDITIONAL INFORMATION

If more than one screen, show locations of each on sketch.