

MISSISSIPPI DEPARTMENT OF NATURAL RESOURCES

Bureau of Land and Water Resources

Southport Mall

P.O. Box 10631

Jackson, Mississippi 39209

WATER WELL DRILLERS LOG

HANCOCK
L 2048
3-10-81

3-10-81

date well completed

WARD WELL DRG. Hancock

firm name

county well located

LANDOWNER: Jim Kelly
General Delivery
Pearlizington, Ms.
(mailing address)

description of formations encountered

from

to

Clay

0 20

Clay SD

20 45

Clay

45 70

Coarse SD

70 110

WELL LOCATION:
sec 20 T 9 N R 16 E
6 miles S/E of Pearlizington
(distance) (direction) (nearest town)

WELL PURPOSE: None
(home, irrigation, municipal, industrial)

WELL COMPLETION DATA:

- (1) diameter (inches) 3"
- (2) total depth (feet) 110
- (3) static water level (feet) 4 ^{below} top of ground
- (4) casing PVC 100
(material) (depth)
- (size) if telescope see back.
- (5) screen 10' (length) (depth to top)
2" (size) PVC (material)
- (6) pump owner (HP) (yield gpm)
(type power)
- (7) electric log NO (yes or no)
N/A (organization running log)
- (8) how well bottom plugged BWU

DRILLERS REMARKS: N/A


DEPT. OF NATURAL RESOURCES
BUREAU OF LAND & WATER RESOURCES

APR 16 1981

RECEIVED

If well telescopes please sketch and show depths.

GROUND LEVEL

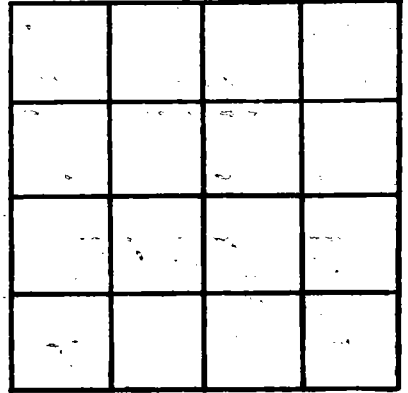

SECTION 20

Please indicate well location X.

ADDITIONAL INFORMATION

If more than one screen,
show locations of each on sketch.