

MISSISSIPPI DEPARTMENT OF NATURAL RESOURCES

Bureau of Land and Water Resources

Southport Mall

P.O. Box 10631

Jackson, Mississippi 39209

WATER WELL DRILLERS LOG

Hancock  
L20587

3-20-

1983

Ward Well Dr.

Hancock

date well completed

firm name

county well located

LANDOWNER:

Doyle White

description of formations encountered

from

to

White Boyen Rd.

Clay

0 15

Rankington, miss.  
(mailing address)

sd

15 28

Clay

28 65

sd

65 86

Clay

86 104

oyster shells

104 126

Clay

126 138

sd

138 165

WELL LOCATION:

sec 32 T 9 N R 16 E  
6 miles N/E of Rankington  
(distance) (direction) (nearest town)

WELL PURPOSE:

Home  
(home, irrigation, municipal, industrial)

WELL COMPLETION DATA:

- (1) diameter (inches) 2"
- (2) total depth (feet) 165
- (3) static water level (feet) 10 <sup>below</sup> above top of ground.
- (4) casing PVC, 155,  
(material) (depth)  
(size) If telescope see back.
- (5) screen 10',  
(length) (depth to top)  
2", PVC  
(size) (material)
- (6) pump owner  
(HP) (yield gpm)  
(type power)
- (7) electric log NO  
(yes or no)  
N/A  
(organization running log)
- (8) how well bottom plugged 3WU

DEPT. OF NATURAL RESOURCES  
BUREAU OF LAND & WATER RESOURCES

APR 22 1983


RECEIVED

DRILLERS REMARKS:

N/A

If well telescopes please sketch and show depths.

GROUND LEVEL

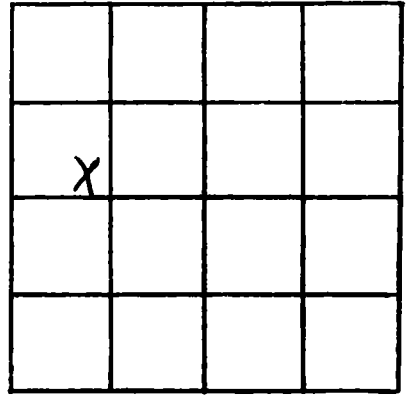

SECTION 39

Please indicate well location X.

ADDITIONAL INFORMATION

If more than one screen,  
show locations of each on sketch.