

MISSISSIPPI DEPARTMENT OF NATURAL RESOURCES

Bureau of Land and Water Resources

Southport Mall

P.O. Box 10631

Jackson, Mississippi 39209

WATER WELL DRILLERS LOG

HANCOCK  
L 2058  
5-10-83

5/10/83 19 Braden Pump & Well Serv. Inc. Hancock  
date well completed firm name county well located

LANDOWNER: Arlene Egan  
P.O. Box 110  
Pearlington, Ms. 39522  
(mailing address)

description of formations encountered	from	to
Clay	0	20
clay + sand	20	40
sand + gravel	40	100
sand	100	120
sand + clay	120	140
Clay	140	160
sand + clay	160	200
Clay	200	220
clay + sand	220	260
sand	260	285
clay	285	300
sand	300	360

WELL LOCATION:  
sec. 20 T. 7 N. R. 16 E.  
S W  
in miles Pearlington  
(distance) (direction) (nearest town)

WELL PURPOSE: Home  
(home, irrigation, municipal, industrial)

WELL COMPLETION DATA:

- (1) diameter (inches) 2"
- (2) total depth (feet) 360
- (3) static water level (feet) 6' below top of ground.
- (4) casing PVC 330 350  
(material) (depth)
- 2"  
(size) If telescope see back.
- (5) screen 10' 330 350  
(length) (depth to top)
- 2" PVC  
(size) (material)
- (6) pump 1/2 10  
(HP) (yield gpm)
- 230 V  
(type power)
- (7) electric log no  
(yes or no)
- (organization running log)
- (8) how well bottom plugged 2" PVC  
sandshank

DRILLERS REMARKS: 20 ft  
tailpipe.


DEPT. OF NATURAL RESOURCES  
BUREAU OF LAND & WATER RESOURCES

MAY 16 1983

**RECEIVED**

If well telescopes please sketch and show depths.

GROUND LEVEL

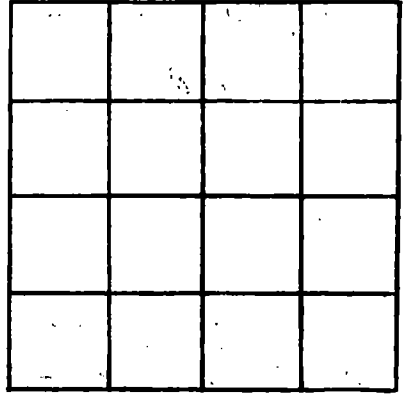

SECTION \_\_\_\_\_

Please indicate well location X.

ADDITIONAL INFORMATION

If more than one screen, show locations of each on sketch.