

MISSISSIPPI DEPARTMENT OF NATURAL RESOURCES

Bureau of Land and Water Resources

Southport Mall

P.O. Box 10631

Jackson, Mississippi 39209

WATER WELL DRILLERS LOG

Hancock
L 2067

9-14-1983 ward well dly. Hancock
date well completed firm name county well located

LANDOWNER: Harvey Consulting Firm
General Delivery
Ridgeland ms.
(mailing address)

description of formations encountered	from	to
<u>Top Soil - clay</u>	<u>0</u>	<u>12</u>
<u>sd</u>	<u>12</u>	<u>27</u>
<u>clay</u>	<u>27</u>	<u>45</u>
<u>sd</u>	<u>45</u>	<u>68</u>
<u>clay</u>	<u>68</u>	<u>94</u>
<u>Red Shale - sd</u>	<u>94</u>	<u>110</u>

WELL LOCATION:
sec. 19 T-9 N R-16 E
3 miles East of Ridgeland
(distance) (direction) (nearest town)

WELL PURPOSE: None
(home, irrigation, municipal, industrial)

WELL COMPLETION DATA:

(1) diameter (inches) 2"

(2) total depth (feet) 110

(3) static water level (feet) 10 below above top of ground.

(4) casing PVC, 100,
(material) (depth)

- if telescope see back.
(size)

(5) screen 10', -
(length) (depth to top)

2", PVC
(size) (material)

(6) pump owner -
(HP) (yield gpm)

-
(type power)

(7) electric log NO
(yes or no)

N/A
(organization running log)

(8) how well bottom plugged BWD

DRILLERS REMARKS: N/A


DEPT. OF NATURAL RESOURCES
BUREAU OF LAND & WATER RESOURCES

NOV - 8 1983

RECEIVED

If well telescopes please sketch and show depths.

GROUND LEVEL

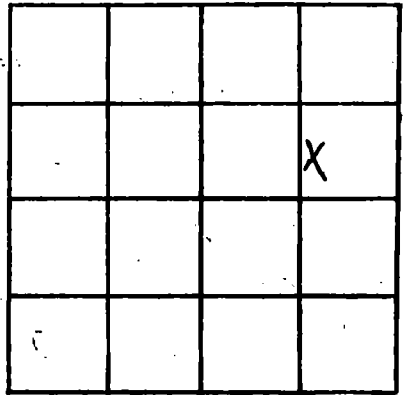

SECTION 19

Please indicate well location X.

ADDITIONAL INFORMATION

If more than one screen,
show locations of each on sketch.