

MISSISSIPPI DEPARTMENT OF NATURAL RESOURCES
 Bureau of Land and Water Resources
 Southport Mall
 P.O. Box 10631
 Jackson, Mississippi 39209
WATER WELL DRILLERS LOG

HANCOCK
L2063

12-5-1983 date well completed Ward Well Dy. firm name Hancock county well located

LANDOWNER: William Flouth
100 Bali Drive
Rearlington, ms.
 (mailing address)

description of formations encountered	from	to
Clay	0	12
sd	12	32
Clay	32	84
sd	84	105

WELL LOCATION:
 sec. 21 T. 9 N. R. 16 E
1 miles S of Rearlington
 (distance) (direction) (nearest town)

WELL PURPOSE: Home
 (home, irrigation, municipal, industrial)

WELL COMPLETION DATA:

(1) diameter (inches) 2"
 (2) total depth (feet) 105
 (3) static water level (feet) 6 ^{below} above top of ground.

(4) casing PVC, 95
 (material) (depth)
 (size) If telescope see back.

(5) screen 10', -
 (length) (depth to top)
2", PVC
 (size) (material)

(6) pump -, -
 (HP) (yield gpm)
 (type power)

(7) electric log NO
 (yes or no)
N/A
 (organization running log)

(8) how well bottom plugged BWU


DRILLERS REMARKS: N/A

DEPT. OF NATURAL RESOURCES
 BUREAU OF LAND & WATER RESOURCES
 JAN 13 1984
RECEIVED

If well telescopes please sketch and show depths.

2004 AH
1

GROUND LEVEL

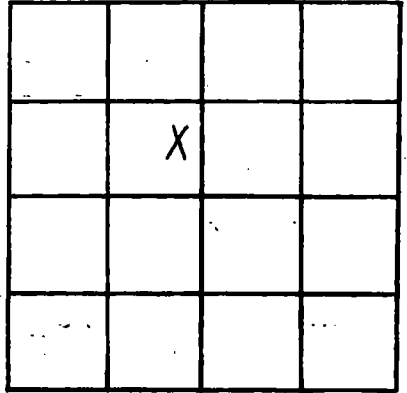

SECTION 21

Please indicate well location X.

ADDITIONAL INFORMATION

If more than one screen, show locations of each on sketch.