

MISSISSIPPI DEPARTMENT OF NATURAL RESOURCES
Bureau of Land and Water Resources
 Southport Mall
 P.O. Box 10631
 Jackson, Mississippi 39209
WATER WELL DRILLERS LOG

Hamcock
L 2068

4-12-

1984 Ward Well Dr.

Hamcock

date well completed

firm name

county well located

LANDOWNER: W. Nixon
Kelly's Fish Camp
Readington, ms.
 (mailing address)

description of formations encountered

from	to
0	18
18	46
46	98
98	120

Clay
sd
Clay
sd

WELL LOCATION:

sec. 27 T 10 N R. 16 E
3 1/2 miles S/E of Readington
 (distance) (direction) (nearest town)

WELL PURPOSE: Camp
 (home, irrigation, municipal, industrial)

WELL COMPLETION DATA:

- (1) diameter (inches) 2"
- (2) total depth (feet) 120'
- (3) static water level (feet) 5 ^{below} above top of ground.
- (4) casing PVC, 110'
 (material) (depth)
— if telescope see back.
 (size)
- (5) screen 10', —
 (length) (depth to top)
2", PVC
 (size) (material)
- (6) pump —, —
 (HP) (yield gpm)
—
 (type power)
- (7) electric log NO
 (yes or no)
N/A
 (organization running log)
- (8) how well bottom plugged BWU

DRILLERS REMARKS: N/A


DEPT. OF NATURAL RESOURCES
 BUREAU OF LAND & WATER RESOURCES

MAY 25 1984

RECEIVED

If well telescopes please sketch and show depths.

GROUND LEVEL

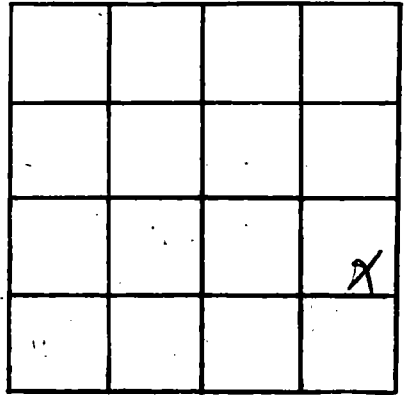

SECTION 22

Please indicate well location X.

ADDITIONAL INFORMATION

If more than one screen,
show locations of each on sketch.