

MISSISSIPPI DEPARTMENT OF NATURAL RESOURCES
Bureau of Land and Water Resources
 Southport Mall
 P.O. Box 10631
 Jackson, Mississippi 39209
WATER WELL DRILLERS LOG

Hancock
L 207D

4-7- 1984 Ward Well Dly. Hancock
 date well completed firm name county well located

LANDOWNER: Edelen Moffett
P.O. Box 166
Reaughton, ms.
 (mailing address)

WELL LOCATION:
 sec 20 T 9 N R 16 E
1 miles S of Reaughton
 (distance) (direction) (nearest town)

WELL PURPOSE: Home
 (home, irrigation, municipal, industrial)

WELL COMPLETION DATA:

(1) diameter (inches) 2"

(2) total depth (feet) 624'

(3) static water level (feet) 1 ^{below}/_{above} top of ground.

(4) casing PVC 604'
 (material) (depth)
 If telescope see back.
 (size)

(5) screen 20' -
 (length) (depth to top)
2" PVC
 (size) (material)

(6) pump owner -
 (HP) (yield gpm)

 (type power)

(7) electric log NO
 (yes or no)
N/A
 (organization running log)

(8) how well bottom plugged BWU

description of formations encountered	from	to
<u>fill-clay</u>	<u>0</u>	<u>18</u>
<u>sd</u>	<u>18</u>	<u>32</u>
<u>clay</u>	<u>32</u>	<u>96</u>
<u>sd</u>	<u>96</u>	<u>128</u>
<u>clay-silt</u>	<u>128</u>	<u>275</u>
<u>fill sd</u>	<u>275</u>	<u>306</u>
<u>clay-silt</u>	<u>306</u>	<u>430</u>
<u>congl sd</u>	<u>430</u>	<u>505</u>
<u>clay</u>	<u>505</u>	<u>516</u>
<u>congl sd</u>	<u>516</u>	<u>624</u>


DEPT. OF NATURAL RESOURCES
 BUREAU OF LAND & WATER RESOURCES

MAY 25 1984
RECEIVED

DRILLERS REMARKS: N/A

If well telescopes please sketch and show depths.

GROUND LEVEL

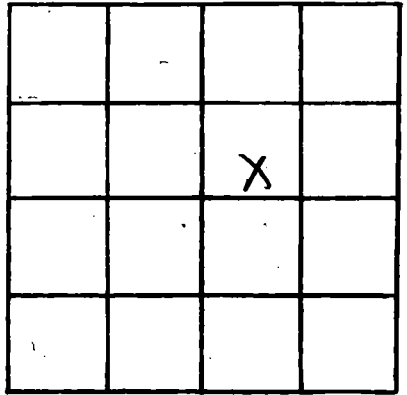

SECTION _____

Please indicate well location X.

ADDITIONAL INFORMATION

If more than one screen, show locations of each on sketch.