

MISSISSIPPI DEPARTMENT OF NATURAL RESOURCES

Bureau of Land and Water Resources

Southport Mall

P.O. Box 10631

Jackson, Mississippi 39209

WATER WELL DRILLERS LOG

Hancock
L 2070

6-11-
date well completed

1984 Ward Well Drg.
firm name

Hancock
county well located

LANDOWNER: Lee Raffield
General Delivery
Pearlington, ms.
(mailing address)

description of formations encountered

from	to
0	15
15	38
38	95
95	126

clay
sd
clay
sd

WELL LOCATION:

sec. 19 T 9 N R 16 E
1 miles N/E of Pearlington
(distance) (direction) (nearest town)

WELL PURPOSE: Home
(home, irrigation, municipal, industrial)

WELL COMPLETION DATA:

- (1) diameter (inches) 2"
- (2) total depth (feet) 126
- (3) static water level (feet) 10 ^{below} above top of ground.
- (4) casing PVC 116
(material) (depth)
- if telescope see back.
(size)
- (5) screen 10' -
(length) (depth to top)
2" PVC
(size) (material)
- (6) pump owner -
(HP) (yield gpm)
-
(type power)
- (7) electric log NO
(yes or no)
N/A
(organization running log)
- (8) how well bottom plugged BWU

DEPT. OF NATURAL RESOURCES
BUREAU OF LAND & WATER RESOURCES


AVG 3 1984

RECEIVED

DRILLERS REMARKS: N/A
over

If well telescopes please sketch and show depths.

GROUND LEVEL

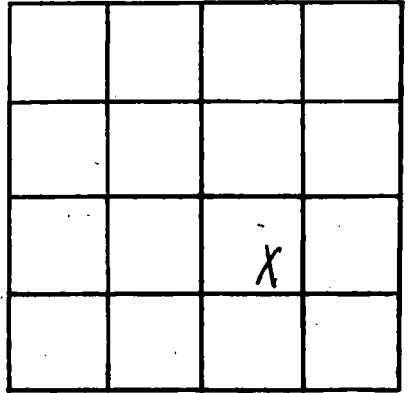

SECTION 19

Please indicate well location X.

ADDITIONAL INFORMATION

The customer is a
Complainer. - Color of water;
Smell; you name it.
We suggested a
Feltner Water Conelator
to fit his need.

If more than one screen,
show locations of each on sketch.