

MISSISSIPPI DEPARTMENT OF NATURAL RESOURCES

Bureau of Land and Water Resources

Southport Mall

P.O. Box 10631

Jackson, Mississippi 39209

WATER WELL DRILLERS LOG

Hancock
L 2074

8-21 1984 Ward Well Dly Hancock
date well completed firm name county well located

LANDOWNER: Douglas Jennie
P.O. Box 319
Pearlington, ms.
(mailing address)

description of formations encountered

from	to
0	21
21	28
28	86
86	109

fill - clay
sd
clay
slt

WELL LOCATION:

sec. 28 T 9 N R. 16 E
2 miles S/E of Pearlington
(distance) (direction) (nearest town)

WELL PURPOSE: Home
(home, irrigation, municipal, industrial)

WELL COMPLETION DATA:

- (1) diameter (inches) 2"
- (2) total depth (feet) 109
- (3) static water level (feet) 8 below top of ground above
- (4) casing PVC 99
(material) (depth)
— if telescope see back.
(size)
- (5) screen 10' —
(length) (depth to top)
2" PVC
(size) (material)
- (6) pump 1/2 10
(HP) (yield gpm)
Elec.
(type power)
- (7) electric log NO
(yes or no)
N/A
(organization running log)
- (8) how well bottom plugged BWV

DRILLERS REMARKS: MA


DEPT. OF NATURAL RESOURCES
BUREAU OF LAND & WATER RESOURCES

OCT 19 1984

RECEIVED

If well telescopes please sketch and show depths.

GROUND LEVEL

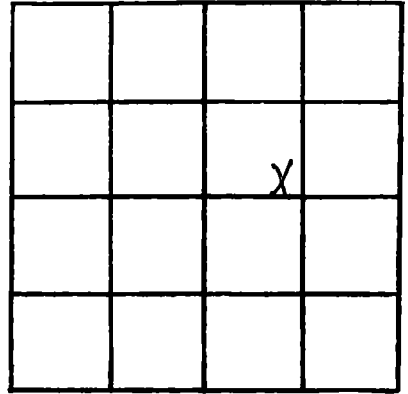

SECTION 28

Please indicate well location X.

ADDITIONAL INFORMATION

If more than one screen, show locations of each on sketch.