

MISSISSIPPI DEPARTMENT OF NATURAL RESOURCES
 Bureau of Land and Water Resources
 Southport Mall
 P.O. Box 10631
 Jackson, Mississippi 39209
WATER WELL DRILLERS LOG

Hancock
 L 2276
 5-16-85

L

5-16-1985 date well completed
 85 Ward Well Drg. firm name
 Hancock county well located

LANDOWNER: William Kornhaus
P.O. Box 303
Ridgely, ms.
 (mailing address)

description of formations encountered	from	to
	Clay	0
sd	26	34
Red gravel	54	65
Clay	65	102
sd	102	115
Clay-silt	115	190
sd	190	230

WELL LOCATION:
 sec. 20 T. 9 N. R. 17 E.
2 miles N of Ridgely
 (distance) (direction) (nearest town)

WELL PURPOSE: None
 (home, irrigation, municipal, industrial)


- WELL COMPLETION DATA:
- diameter (inches) 2"
 - total depth (feet) 230
 - static water level (feet) 8 ^{below} _{above} top of ground.
 - casing PVC, 220,
 (material) (depth)
— If telescope see back.
 (size)
 - screen 10, —
 (length) (depth to top)
2", PVC
 (size) (material)
 - pump owner, —
 (HP) (yield gpm)
—
 (type power)
 - electric log NO
 (yes or no)
N/A
 (organization running log)
 - how well bottom plugged BMW

RECEIVED
 JUL 12 1985

DRILLERS REMARKS: N/A

If well telescopes please sketch and show depths.

GROUND LEVEL

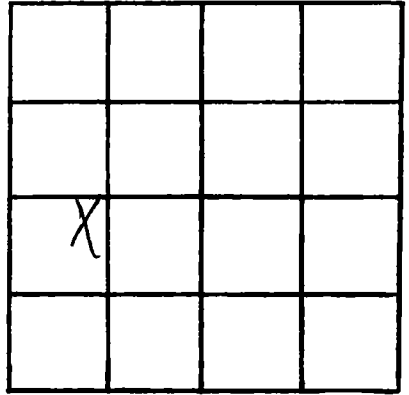

SECTION 20

Please indicate well location X.

ADDITIONAL INFORMATION

If more than one screen, show locations of each on sketch.