

MISSISSIPPI DEPARTMENT OF NATURAL RESOURCES

Bureau of Land and Water Resources

Southport Mall

P.O. Box 10631

Jackson, Mississippi 39209

WATER WELL DRILLERS LOG

L ~~2087~~ 2080
 Hancock
 7-25-85

July 25 1985 Wood Well Drly Hancock
 Date well completed firm name county well located

LANDOWNER: Frank Marquer
 No. 9 Maui Rd.
 Rowlington, ms.
 (mailing address)

description of formations encountered

from to

Clay	0	20
SD	20	32
Clay	32	98
SD	98	120

WELL LOCATION:

sec 28 T 9 N R 16 E
 1 miles S of Rowlington
 (distance) (direction) (nearest town)

WELL PURPOSE: Home
 (home, irrigation, municipal, industrial)

WELL COMPLETION DATA:

- (1) diameter (inches) 2"
- (2) total depth (feet) 120
- (3) static water level (feet) 8 below top of ground.
- (4) casing PVC, 110 (material) (depth)
 (size) If telescope see back.
- (5) screen 10' (length) (depth to top)
 2" PVC (size) (material)
- (6) pump burner (HP) (yield gpm)
 (type power)
- (7) electric log NO (yes or no)
 N/A (organization running log)
- (8) how well bottom plugged BWW

RECEIVED


SEP 26 1985

DRILLERS REMARKS: N/A

Department of Natural Resources
 Bureau of Land & Water Resources

If well telescopes please sketch and show depths.

GROUND LEVEL

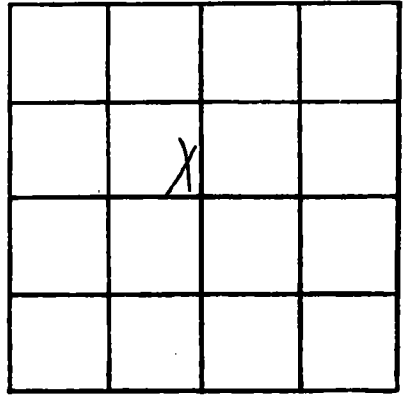

SECTION 28

Please indicate well location X.

ADDITIONAL INFORMATION

If more than one screen,
show locations of each on sketch.