

MISSISSIPPI DEPARTMENT OF NATURAL RESOURCES

Bureau of Land and Water Resources

Southport Mall

P.O. Box 10631

Jackson, Mississippi 39209

WATER WELL DRILLERS LOG

Hancock
L 20801

Sept. 18 1985 Ward Well Dlg. Hancock
date well completed firm name county well located

LANDOWNER: Jim Baldue
P.O. Box 213
Healington, ms.
(mailing address)

WELL LOCATION:
sec 21 T 9 N R 16 E
Healington
(distance) miles (direction) of (nearest town)

WELL PURPOSE: Home
(home, irrigation, municipal, industrial)

WELL COMPLETION DATA:
(1) diameter (inches) 2"
(2) total depth (feet) 106'
(3) static water level (feet) 5 ^{below} above top of ground.
(4) casing PVC 96
(material) (depth)
- if telescope see back.
(size)
(5) screen 10' -
(length) (depth to top)
2" PVC
(size) (material)
(6) pump curran -
(HP) (yield gpm)
(type power)
(7) electric log N D
(yes or no)
N/A
(organization running log)
(8) how well bottom plugged BWJ

description of formations encountered	from	to
<u>Sandy Soil</u>	<u>0</u>	<u>4</u>
<u>Clay</u>	<u>4</u>	<u>21</u>
<u>sd</u>	<u>21</u>	<u>34</u>
<u>Clay</u>	<u>34</u>	<u>48</u>
<u>Red gravel - sd</u>	<u>48</u>	<u>72</u>
<u>Clay</u>	<u>72</u>	<u>88</u>
<u>Coar sd</u>	<u>88</u>	<u>106</u>


RECEIVED
NOV 20 1985

Department of Natural Resources
Bureau of Land & Water Resources

DRILLERS REMARKS: N/A

If well telescopes please sketch and show depths.

GROUND LEVEL

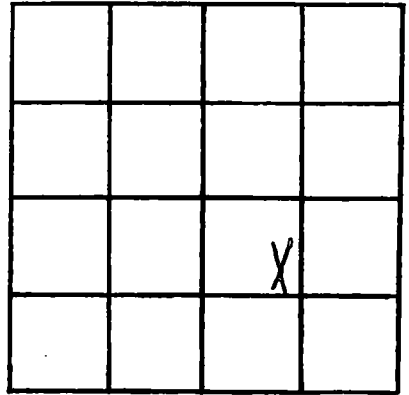

SECTION 21

Please indicate well location X.

ADDITIONAL INFORMATION

If more than one screen, show locations of each on sketch.