

MISSISSIPPI DEPARTMENT OF NATURAL RESOURCES

Bureau of Land and Water Resources

Southport Mall

P.O. Box 10631

Jackson, Mississippi 39209

WATER WELL DRILLERS LOG

Hancock  
L 2082

Sept. 27

1985 Ward Well Drg.

Hancock

date well completed

firm name

county well located

LANDOWNER: Franklin Dalryp

description of formations encountered

from

to

Cherry Dr.

clay

0

16

Readington Ms.  
(mailing address)

sd

16

35

clay

35

52

open gravel

52

68

clay

68

102

cone sd

102

126

WELL LOCATION:

sec. 17 T. 9 N R. 16 E

1 miles N of Readington  
(distance) (direction) (nearest town)

WELL PURPOSE: Home  
(home, irrigation, municipal, industrial)

WELL COMPLETION DATA:

- (1) diameter (inches) 2"
- (2) total depth (feet) 126'
- (3) static water level (feet) 10 <sup>below</sup> <sub>above</sub> top of ground.

- (4) casing PVC 116  
(material) (depth)

- (size) if telescope see back.

- (5) screen 10' -  
(length) (depth to top)

2" PVC  
(size) (material)

- (6) pump owner -  
(HP) (yield gpm)

- (type power)

- (7) electric log NO  
(yes or no)

N/A  
(organization running log)

- (8) how well bottom plugged BWV


DRILLERS REMARKS: N/A

**RECEIVED**  
NOV 20 1985

Department of Natural Resources  
Bureau of Land & Water Resources

If well telescopes please sketch and show depths.

GROUND LEVEL

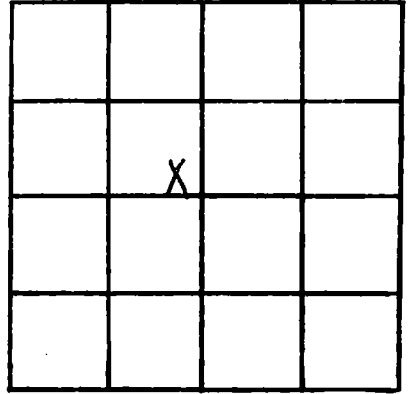

SECTION 17

Please indicate well location X.

ADDITIONAL INFORMATION

If more than one screen, show locations of each on sketch.