

MISSISSIPPI DEPARTMENT OF NATURAL RESOURCES

Bureau of Land and Water Resources

Southport Mall

P.O. Box 10631

Jackson, Mississippi 39209

WATER WELL DRILLERS LOG

Hancock
L20873

March 21 1986 Ward Well Dr. Hancock
date well completed firm name county well located

LANDOWNER Rich DeStacy
General Delivery
Reulington ms.
(mailing address)

description of formations encountered	from	to
Clay	0	21
sd	21	36
Clay - silty	36	55
Red-brown-sd	55	68
Clay	68	104
sd	104	125

WELL LOCATION:
sec. 17 T 9 N R 16 E
1 miles NW Reulington
(distance) (direction) (nearest town)

WELL PURPOSE: None
(home, irrigation, municipal, industrial)

- WELL COMPLETION DATA:
- (1) diameter (inches) 2
 - (2) total depth (feet) 125
 - (3) static water level (feet) 6 below above top of ground.
 - (4) casing PVC 105
(material) (depth)
— (size) If telescope see back.
 - (5) screen 10' —
(length) (depth to top)
2" PVC
(size) (material)
 - (6) pump owner
(HP) (yield gpm)
— (type power)
 - (7) electric log no
(yes or no)
N/A
(organization running log)
 - (8) how well bottom plugged BW


DRILLERS REMARKS: N/A

RECEIVED
MAY 12 1986

Department of Natural Resources
Bureau of Land & Water

If well telescopes please sketch and show depths.

GROUND LEVEL

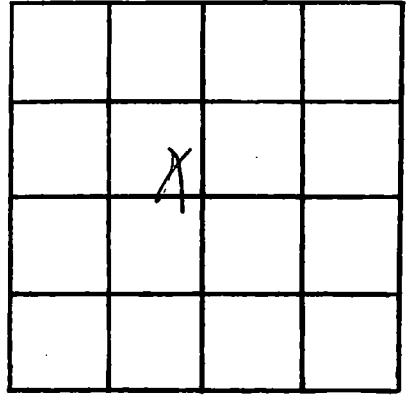

SECTION 17

Please indicate well location X.

ADDITIONAL INFORMATION

If more than one screen, show locations of each on sketch.