

MISSISSIPPI DEPARTMENT OF NATURAL RESOURCES

Bureau of Land and Water Resources

Southport Mall

P.O. Box 10631

Jackson, Mississippi 39209

WATER WELL DRILLERS LOG

HANCOCK
~~L 2087~~
L 2084

March 24 1986 Wood Well Pkg. Hancock
 date well completed firm name county well located

LANDOWNER: Jeffrey R. Wood
P.O. Box #18
Reidlight, ms.
 (mailing address)

description of formations encountered	from	to
	<u>fill-clay</u>	<u>0</u>
<u>clay</u>	<u>22</u>	<u>30</u>
<u>sd</u>	<u>30</u>	<u>88</u>
<u>sd</u>	<u>88</u>	<u>110</u>

WELL LOCATION:
 sec. 26 T. 9 N. R. 16 E.
1/4 miles S of Reidlight
 (distance) (direction) (nearest town)

WELL PURPOSE: Home
 (home, irrigation, municipal, industrial)


- WELL COMPLETION DATA:
- (1) diameter (inches) 2'
 - (2) total depth (feet) 110
 - (3) static water level (feet) 5 ^(below) above top of ground.
 - (4) casing PVC, 100,
 (material) (depth)
 (size) if telescope see back.
 - (5) screen 10',
 (length) (depth to top)
2", PVC
 (size) (material)
 - (6) pump crane,
 (HP) (yield gpm)
 (type power)
 - (7) electric log NO
 (yes or no)
N/A
 (organization running log)
 - (8) how well bottom plugged BWV

DRILLERS REMARKS: N/A

RECEIVED
 MAY 12 1986

If well telescopes please sketch and show depths.

GROUND LEVEL

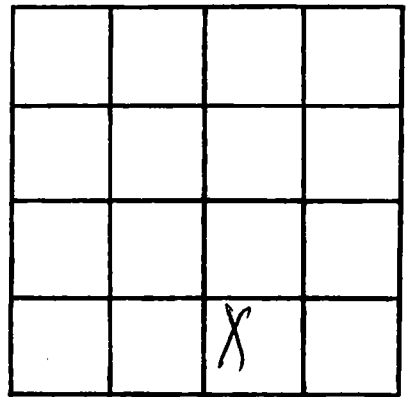

SECTION 28

Please indicate well location X.

ADDITIONAL INFORMATION

A series of horizontal lines for writing additional information.

If more than one screen, show locations of each on sketch.