

MISSISSIPPI DEPARTMENT OF NATURAL RESOURCES

Bureau of Land and Water Resources

Southport Mall

P.O. Box 10631

Jackson, Mississippi 39209

WATER WELL DRILLERS LOG

HANCOCK
~~L 2086~~
2085

March 25 1986 date well completed
 86 Ward Well Dr. firm name
 Hancock county well located

LANDOWNER: Timothy Smith
P.O. Box 124
Revelight, Ms.
 (mailing address)

WELL LOCATION:
 sec. 17 T. 9 N R. 16 E
1 miles N/W of Revelight
 (distance) (direction) (nearest town)


WELL PURPOSE: None
 (home, irrigation, municipal, industrial)

WELL COMPLETION DATA:

(1) diameter (inches) 2"
 (2) total depth (feet) 120
 (3) static water level (feet) 7 ^{below} above top of ground.
 (4) casing PVC, 110,
 (material) (depth)
— If telescope see back.
 (size)
 (5) screen 10' —
 (length) (depth to top)
2", PVC
 (size) (material)
 (6) pump owner —
 (HP) (yield gpm)
—
 (type power)
 (7) electric log NO
 (yes or no)
N/A
 (organization running log)
 (8) how well bottom plugged BWV

description of formations encountered	from	to
<u>Fill - clay</u>	<u>0</u>	<u>18</u>
<u>Sd</u>	<u>18</u>	<u>35</u>
<u>Clay - silt</u>	<u>35</u>	<u>58</u>
<u>Red gravel - Sd</u>	<u>58</u>	<u>66</u>
<u>Clay - silt</u>	<u>66</u>	<u>98</u>
<u>Sd</u>	<u>98</u>	<u>120</u>


DRILLERS REMARKS: N/A

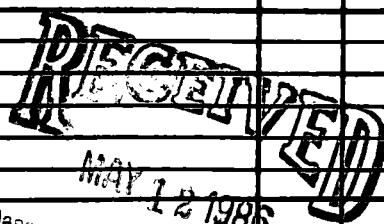

Department of Natural Resources
 Bureau of Land & Water Resources

If well telescopes please sketch and show depths.

GROUND LEVEL

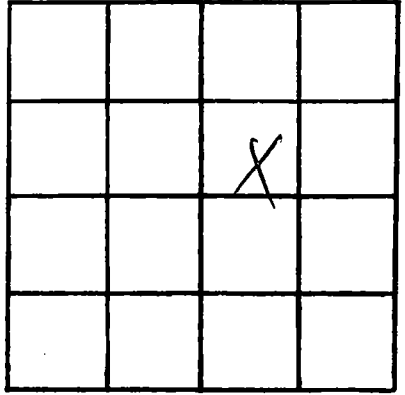

SECTION 17

Please indicate well location X.

ADDITIONAL INFORMATION

Lined area for additional information.

If more than one screen, show locations of each on sketch.