

MISSISSIPPI DEPARTMENT OF NATURAL RESOURCES

Bureau of Land and Water Resources

Southport Mall

P.O. Box 10631

Jackson, Mississippi 39209

WATER WELL DRILLERS LOG

Hancock
~~L 2000~~
2086

March 25 1986 Ward Well Drg. Hancock
 date well completed firm name county well located

LANDOWNER: Zachary Hunt
P.O. Box 227
Beaumont, ms.
 (mailing address)

WELL LOCATION:
 sec. 17 T. 9 N R. 16 E
1 miles NW of Beaumont
 (distance) (direction) (nearest town)

WELL PURPOSE: Home
 (home, irrigation, municipal, industrial)

WELL COMPLETION DATA:
 (1) diameter (inches) 2"
 (2) total depth (feet) 125'
 (3) static water level (feet) 7 (below/above top of ground)
 (4) casing PVC 115'
 (material) (depth)
 (size) If telescope see back.
 (5) screen 10' -
 (length) (depth to top)
2" PVC
 (size) (material)
 (6) pump none -
 (HP) (yield gpm)
 (type power)
 (7) electric log NO
 (yes or no)
N/A
 (organization running log)
 (8) how well bottom plugged BWV

description of formations encountered	from	to
<u>fill - clay</u>	<u>0</u>	<u>22</u>
<u>clay silt</u>	<u>22</u>	<u>35</u>
<u>clay silt</u>	<u>35</u>	<u>56</u>
<u>SC - Red Shale</u>	<u>56</u>	<u>68</u>
<u>Clay - silt</u>	<u>68</u>	<u>105</u>
<u>SC</u>	<u>105</u>	<u>125</u>


DRILLERS REMARKS: N/A

RECEIVED
 MAY 12 1986

Department of Natural Resources
 Bureau of Land & Water Resources

If well telescopes please sketch and show depths.

GROUND LEVEL

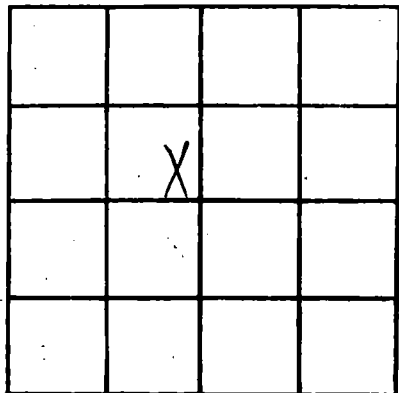

SECTION 17

Please indicate well location X.

ADDITIONAL INFORMATION

If more than one screen, show locations of each on sketch.