

MISSISSIPPI DEPARTMENT OF NATURAL RESOURCES

Bureau of Land and Water Resources

Southport Mall

P.O. Box 10631

Jackson, Mississippi 39209

WATER WELL DRILLERS LOG

HAWCOCK
L 20887

May 23 1986 Ward Well Dlg Hancock
date well completed firm name county well located

LANDOWNER: Ben Nune Jr.
Heon Bay Est.
Analy, ms.
(mailing address)

description of formations encountered	from	to
<u>fill</u>	<u>0</u>	<u>3</u>
<u>clay</u>	<u>3</u>	<u>15</u>
<u>sd</u>	<u>15</u>	<u>38</u>
<u>clay</u>	<u>38</u>	<u>95</u>
<u>sd</u>	<u>95</u>	<u>149</u>

WELL LOCATION:
33 T 10 N R 15 E 6 S
17 miles S/W of Wardland
(distance) (direction) (nearest town)

WELL PURPOSE: Home
(home, irrigation, municipal, industrial)

WELL COMPLETION DATA:

(1) diameter (inches) 2"

(2) total depth (feet) 149

(3) static water level (feet) 6 below above top of ground.

(4) casing PVC, 139,
(material) (depth)
- If telescope see back.
(size)

(5) screen 10', -
(length) (depth to top)
2", PVC
(size) (material)

(6) pump none, -
(HP) (yield gpm)
- (type power)

(7) electric log NO
(yes or no)
N/A
(organization running log)

(8) how well bottom plugged BWD

RECEIVED


AUG 4 1986

Department of Natural Resources
Bureau of Land & Water Resources

DRILLERS REMARKS: N/A

If well telescopes please sketch and show depths.

GROUND LEVEL

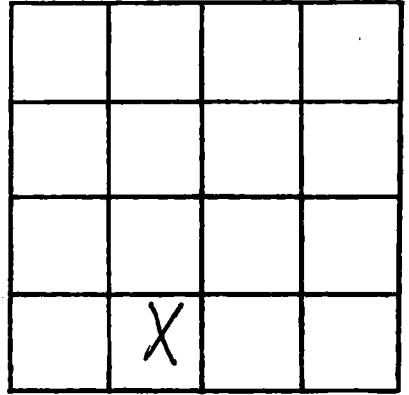

SECTION 33

Please indicate well location X.

ADDITIONAL INFORMATION

If more than one screen, show locations of each on sketch.